


1 LOCATION OF WATER WELL: Fraction SE 1/4 NE 1/4 NW 1/4 Section Number 31 Township Number T 28 S Range Number R 8 E
 County: KINGMAN

Distance and direction from nearest town or city street address of well if located within city?

4 Miles South 1/2 West 1 Mile West 1/4 Mile South Of Kingman, Kns.

2 WATER WELL OWNER: Lawrence Simons
 RR#, St. Address, Box #: 135 East Jewell Board of Agriculture, Division of Water Resources
 City, State, ZIP Code: Kingman, Kans. 67068 Application Number:

3 LOCATE WELL'S LOCATION WITH AN "X" IN SECTION BOX:

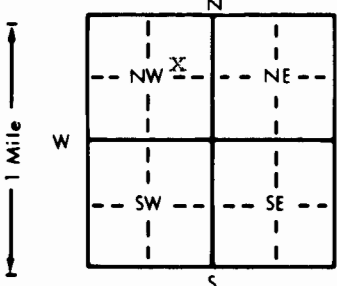

4 DEPTH OF COMPLETED WELL: 108' ft. ELEVATION:
 Depth(s) Groundwater Encountered 1. 47' ft. 2. ft. 3. ft.
 WELL'S STATIC WATER LEVEL: 41' ft. below land surface measured on mo/day/yr Aug. 11, 1998
 Pump test data: Well water was ft. after hours pumping gpm
 Est. Yield 30 gpm: Well water was NA ft. after hours pumping gpm
 Bore Hole Diameter: 8 1/4 in. to 108 in. to in. to in.
 WELL WATER TO BE USED AS: 5 Public water supply 8 Air conditioning 11 Injection well
 1 Domestic XX 3 Feedlot 6 Oil field water supply 9 Dewatering 12 Other (Specify below)
 2 Irrigation 4 Industrial 7 Lawn and garden only 10 Monitoring well
 Was a chemical/bacteriological sample submitted to Department? Yes.....No.....X.....; If yes, mo/day/yr sample was sub-
 mitted Water Well Disinfected? Yes XX No

5 TYPE OF BLANK CASING USED: 5 Wrought iron 8 Concrete tile CASING JOINTS: Glued XX Clamped
 1 Steel 3 RMP (SR) 6 Asbestos-Cement 9 Other (specify below) Welded
 2 PVC XX 4 ABS 7 Fiberglass Threaded
 Blank casing diameter: 5 in. to 98' ft., Dia. in. to ft., Dia. in. to ft.
 Casing height above land surface: 26" in., weight 2' 355 lbs./ft. Wall thickness or gauge No. 2.14
 TYPE OF SCREEN OR PERFORATION MATERIAL: 7 PVC XX 10 Asbestos-cement
 1 Steel 3 Stainless steel 5 Fiberglass 8 RMP (SR) 11 Other (specify)
 2 Brass 4 Galvanized steel 6 Concrete tile 9 ABS 12 None used (open hole)
 SCREEN OR PERFORATION OPENINGS ARE: 5 Gauzed wrapped 8 Saw cut XX 11 None (open hole)
 1 Continuous slot 3 Mill slot 6 Wire wrapped 9 Drilled holes
 2 Louvered shutter 4 Key punched 7 Torch cut 10 Other (specify)
 SCREEN-PERFORATED INTERVALS: From 98' ft. to 108' ft., From ft. to ft.
 From ft. to ft., From ft. to ft.
 GRAVEL PACK INTERVALS: From ft. to ft., From ft. to ft.
 From 108 ft. to 22' ft., From ft. to ft.

6 GROUT MATERIAL: 1 Neat cement 2 Cement grout 3 Bentonite XX 4 Other
 Grout Intervals: From 22' ft. to 0' ft., From ft. to ft., From ft. to ft.
 What is the nearest source of possible contamination: 10 Livestock pens 14 Abandoned water well XX
 1 Septic tank 4 Lateral lines 7 Pit privy 11 Fuel storage 15 Oil well/Gas well
 2 Sewer lines 5 Cess pool 8 Sewage lagoon 12 Fertilizer storage 16 Other (specify below)
 3 Watertight sewer lines 6 Seepage pit 9 Feedyard 13 Insecticide storage
 Direction from well? North How many feet? App: 400'

FROM	TO	LITHOLOGIC LOG	FROM	TO	PLUGGING INTERVALS
0'	4'	Top Soil (Very Hard).			
4'	6'	Clay.			
6'	11'	Medium Fine Sand.			
11'	22'	Clay.			
22'	31'	Fine Sand.			
31'	47'	Medium Course Sand W/Clay Strips.			
47'	60'	Clay.			
60'	90'	Fine Sand.			
90'	108'	Course Sand (Very Course).			
	108'	Red Bed.			

7 CONTRACTOR'S OR LANDOWNER'S CERTIFICATION: This water well was (1) constructed, (2) reconstructed, or (3) plugged under my jurisdiction and was completed on (mo/day/year) Aug. 11, 1998 and this record is true to the best of my knowledge and belief. Kansas Water Well Contractor's License No. 112 This Water Well Record was completed on (mo/day/yr) Aug. 27, 1998 under the business name of Wells Drilling Co. by (signature) Dal Wells