

WATER WELL RECORD Form WWC-5


Original Record Correction Change in Well Use

Division of Water Resources App. No. 20170034

Well ID

1 LOCATION OF WATER WELL: County: KINGMAN Fraction: 1/2 SE 1/4 SW 1/4 Section Number: 22 Township Number: T 28 S Range Number: R 8 E W

2 WELL OWNER: Last Name: Vincent Oil Corporation First: Street or Rural Address where well is located (if unknown, distance and direction from nearest town or intersection): If at owner's address, check here:
 Business: Vincent Oil Corporation Address: 200 W. DOUGLAS AVE. # 725 From Kingman 4 miles South on Hwy 14 To SW 1/4
 Address: 200 W. DOUGLAS AVE. # 725 City: Wichita State: KS ZIP: 67202 ST. THOMAS 3 3/4 WEST NORTH TO WELL

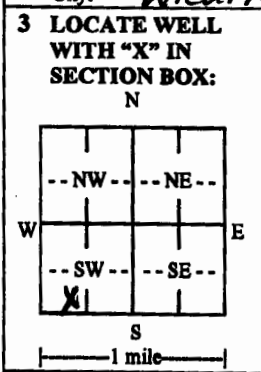

4 DEPTH OF COMPLETED WELL: 120 ft.

Depth(s) Groundwater Encountered: 1) ft.
 2) ft. 3) ft., or 4) Dry Well

WELL'S STATIC WATER LEVEL: 7.0 ft.
 below land surface, measured on (mo-day-yr).....
 above land surface, measured on (mo-day-yr) 2-27-17

Pump test data: Well water was ft. after hours pumping gpm
 Well water was ft. after hours pumping gpm
 Estimated Yield: 1.00 gpm
 Bore Hole Diameter: 1.75 in. to 1.20 ft. and in. to ft.

5 Latitude: (decimal degrees)
Longitude: (decimal degrees)
 Horizontal Datum: WGS 84 NAD 83 NAD 27
 Source for Latitude/Longitude:
 GPS (unit make/model: (WAAS enabled? Yes No)
 Land Survey Topographic Map
 Online Mapper:

6 Elevation: ft. Ground Level TOC
 Source: Land Survey GPS Topographic Map
 Other

7 WELL WATER TO BE USED AS:

1. Domestic: Household Lawn & Garden Livestock
 2. Irrigation
 3. Feedlot
 4. Industrial

5. Public Water Supply: well ID

6. Dewatering: how many wells?

7. Aquifer Recharge: well ID

8. Monitoring: well ID

9. Environmental Remediation: well ID

Air Sparge Soil Vapor Extraction
 Recovery Injection

10. Oil Field Water Supply: lease Robinson 1-22

11. Test Hole: well ID
 Cased Uncased Geotechnical

12. Geothermal: how many bores?
 a) Closed Loop Horizontal Vertical
 b) Open Loop Surface Discharge Inj. of Water

13. Other (specify):

Was a chemical/bacteriological sample submitted to KDHE? Yes No If yes, date sample was submitted:

Water well disinfected? Yes No

8 TYPE OF CASING USED: Steel PVC Other CASING JOINTS: Glued Clamped Welded Threaded

Casing diameter 2 in. to 1.20 ft., Diameter in. to ft., Diameter in. to ft.
 Casing height above land surface 24 in. Weight 1.62 lbs./ft. Wall thickness or gauge No.

TYPE OF SCREEN OR PERFORATION MATERIAL:
 Steel Stainless Steel Fiberglass PVC Other (Specify)
 Brass Galvanized Steel Concrete tile None used (open hole)

SCREEN OR PERFORATION OPENINGS ARE:
 Continuous Slot Mill Slot Gauze Wrapped Torch Cut Drilled Holes Other (Specify)
 Louvered Shutter Key Punched Wire Wrapped Saw Cut None (Open Hole)

SCREEN-PERFORATED INTERVALS: From 120 ft. to 120 ft., From ft. to ft., From ft. to ft.
 GRAVEL PACK INTERVALS: From 120 ft. to 21 ft., From ft. to ft., From ft. to ft.

9 GROUT MATERIAL: Neat cement Cement grout Bentonite Other

Grout Intervals: From 21 ft. to 0 ft., From ft. to ft., From ft. to ft.

Nearest source of possible contamination:
 Septic Tank Lateral Lines Pit Privy Livestock Pens Insecticide Storage
 Sewer Lines Cess Pool Sewage Lagoon Fuel Storage Abandoned Water Well
 Watertight Sewer Lines Seepage Pit Feedyard Fertilizer Storage Oil Well/Gas Well
 Other (Specify)

Direction from well? 999 Distance from well? 999 ft.

10 FROM	TO	LITHOLOGIC LOG	FROM	TO	LITHO. LOG (cont.) or PLUGGING INTERVALS
	<u>4</u>	<u>BLK CLAY TOP SOIL</u>			
	<u>4</u>	<u>COARSE SAND</u>			
	<u>48</u>	<u>TAN CLAY</u>			
	<u>51</u>	<u>SANDSTONE</u>			
	<u>54</u>	<u>COARSE SAND</u>			
	<u>110</u>	<u>COARSE GRAVEL</u>			
	<u>118</u>	<u>RED CLAY</u>			
Notes:					

11 CONTRACTOR'S OR LANDOWNER'S CERTIFICATION: This water well was constructed, reconstructed, or plugged under my jurisdiction and was completed on (mo-day-year) 2-27-17 and this record is true to the best of my knowledge and belief. Kansas Water Well Contractor's License No. 6723. This Water Well Record was completed on (mo-day-year) 2-28-17 under the business name of Chowdria, Wilbur, LLC, SW. Signature: [Signature]

Mail 1 white copy along with a fee of \$5.00 for each constructed well to: Kansas Department of Health and Environment, Bureau of Water, GWTS Section, 1000 SW Jackson St., Suite 420, Topeka, Kansas 66612-1367. Mail one to Water Well Owner and retain one for your records. Telephone 785-296-5524.