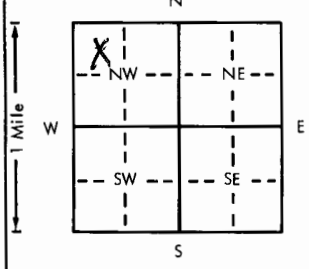


USE TYPEWRITER OR BALL
POINT PEN-PRESS FIRMLY,
PRINT CLEARLY.

WATER WELL RECORD
KSA 82a-1201-1215

Kansas Department of Health and
Environment-Division of Environment
(Water well Contractors)
Topeka, Kansas 66620

1. Location of well:		County Kingman	Fraction 1/4 CNE 1/4 NW 1/4	Section number 11	Township number T 28 S	Range number R 9 W
2. Distance and direction from nearest town or city: 1 S Street address of well location if in city: Calista KS			3. Owner of well: H-30 Drilling Inc R.R. or street: 200 N MAIN City, state, zip code: Wichita, KS 67202			
4. Locate with "X" in section below:		Sketch map:		6. Bore hole dia. 7 in. Completion date 5-13-77 Well depth 97 ft.		
				7. <input checked="" type="checkbox"/> Cable tool <input checked="" type="checkbox"/> Rotary <input type="checkbox"/> Driven <input type="checkbox"/> Dug <input type="checkbox"/> Hollow rod <input type="checkbox"/> Jetted <input type="checkbox"/> Bored <input type="checkbox"/> Reverse rotary		
5. Type and color of material				8. Use: <input type="checkbox"/> Domestic <input type="checkbox"/> Public supply <input type="checkbox"/> Industry <input type="checkbox"/> Irrigation <input type="checkbox"/> Air conditioning <input type="checkbox"/> Stock <input type="checkbox"/> Lawn <input checked="" type="checkbox"/> Oil field water <input type="checkbox"/> Other		
				9. Casing: Material <input type="checkbox"/> Height: Above or below Threaded <input type="checkbox"/> Welded <input type="checkbox"/> Surface 12 in. RMP <input type="checkbox"/> PVC <input checked="" type="checkbox"/> Weight 12 lbs./ft. Dia. 4 in. to 97 ft. depth Wall Thickness: inches or Dia. 4 in. to 97 ft. depth gage No. Sec 40		
				10. Screen: Manufacturer's name MPI Type PVC Dia. 4 Slot/gauze 1/16" Length 20 Set between 72 ft. and 97 ft. Gravel pack? <input checked="" type="checkbox"/> Size range of material 1/2"-3/4"		
				11. Static water level: 34 ft. below land surface Date 5-13-77		
				12. Pumping level below land surfaces: ____ ft. after ____ hrs. pumping ____ g.p.m. ____ ft. after ____ hrs. pumping ____ g.p.m. Estimated maximum yield 75 g.p.m.		
				13. Water sample submitted: ____ mo./day/yr. Yes <input checked="" type="checkbox"/> No <input type="checkbox"/> Date ____		
				14. Well head completion: ____ Pitless adapter 12 inches above grade		
				15. Well grouted? <input checked="" type="checkbox"/> With: <input checked="" type="checkbox"/> Neat cement <input checked="" type="checkbox"/> Bentonite <input type="checkbox"/> Concrete Depth: From 0 ft. to 10 ft.		
				16. Nearest source of possible contamination: oil test ft. 80 Direction NE Type test Well disinfected upon completion? ____ Yes <input checked="" type="checkbox"/> No <input type="checkbox"/>		
				17. Pump: <input checked="" type="checkbox"/> Not installed Manufacturer's name ____ Model number ____ HP ____ Volts ____ Length of drop pipe ____ ft. capacity ____ g.p.m. Type: <input type="checkbox"/> Submersible <input type="checkbox"/> Turbine <input type="checkbox"/> Jet <input type="checkbox"/> Reciprocating <input type="checkbox"/> Centrifugal <input type="checkbox"/> Other		
(Use a second sheet if needed)						
18. Elevation:		19. Remarks:		20. Water well contractor's certification: This well was drilled under my jurisdiction and this report is true to the best of my knowledge and belief. 186 Kellys Water Well Serv. Inc Business name R2, Great Bend, KS License No. ____ Address Kelly Price Date 8-20-77 Signed Kelly Price Authorized representative		