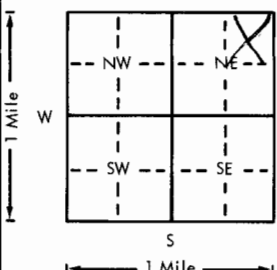
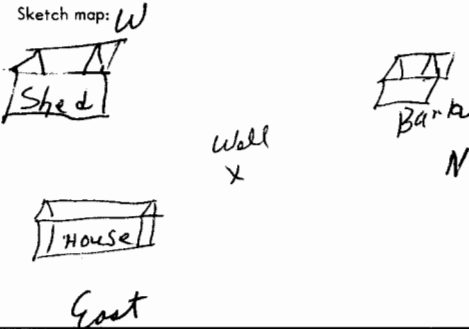


USE TYPEWRITER OR BALL
POINT PEN-PRESS FIRMLY,
PRINT CLEARLY.

WATER WELL RECORD
KSA 82a-1201-1215

Kansas Department of Health and
Environment-Division of Environment
(Water well Contractors)
Topeka, Kansas 66620

1. Location of well:		County <u>Leavenworth</u>	Fraction <u>3/4</u> <u>1/4</u> <u>1/4</u>	Section number <u>32</u>	Township number T <u>28</u> S R <u>9</u>	Range number <u>9</u> E/W
2. Distance and direction from nearest town or city: <u>3 miles North West Leavenworth</u> Street address of well location if in city: <u>Leavenworth</u>			3. Owner of well: <u>Alfred Kladas Mex.</u> R.R. or street: City, state, zip code: <u>Leavenworth Kansas 66045</u>			
4. Locate with "X" in section below: 		Sketch map: 		6. Bore hole dia. <u>8</u> in. Completion date <u>10 21 77</u> Well depth <u>80</u> ft.		
5. Type and color of material		From	To	7. <input checked="" type="checkbox"/> Cable tool <input checked="" type="checkbox"/> Rotary <input type="checkbox"/> Driven <input type="checkbox"/> Dug <input type="checkbox"/> Hollow rod <input type="checkbox"/> Jetted <input type="checkbox"/> Bored <input type="checkbox"/> Reverse rotary		
				8. Use: <input checked="" type="checkbox"/> Domestic <input type="checkbox"/> Public supply <input type="checkbox"/> Industry <input type="checkbox"/> Irrigation <input type="checkbox"/> Air conditioning <input type="checkbox"/> Stock <input type="checkbox"/> Lawn <input type="checkbox"/> Oil field water <input type="checkbox"/> Other		
				10. Screen: Manufacturer's name <u>True & Loush</u> Type <u>RVC</u> Dia. <u>5"</u> Slot/gauze <u>1/16</u> Length <u>10</u> Set between <u>70</u> ft. and <u>80</u> ft. Gravel pack? <input checked="" type="checkbox"/> Size range of material <u>1/4</u>		
				11. Static water level: <u>60</u> ft. below land surface Date <u>10 21 77</u> mo./day/yr.		
				13. Water sample submitted: <u>14</u> mo./day/yr. <input checked="" type="checkbox"/> Yes <input type="checkbox"/> No Date <u>10 21 77</u>		
				14. Well head completion: <u>Well House</u> <input type="checkbox"/> Pitless adapter <u>2 feet</u> Inches <u>above</u> grade		
				15. Well grouted? <input checked="" type="checkbox"/> With: <input checked="" type="checkbox"/> Neat cement <input type="checkbox"/> Bentonite <input type="checkbox"/> Concrete Depth: From <u>1</u> ft. to <u>10</u> ft.		
				16. Nearest source of possible contamination: <u>Septic Tank</u> ft. <u>60</u> Direction <u>East</u> Type <u>Human</u> Well disinfected upon completion? <input checked="" type="checkbox"/> Yes <input type="checkbox"/> No		
				17. Pump: Manufacturer's name <u>Brinkley Jet Pump</u> Model number <u>HL 20</u> HP <u>1/2</u> Volts <u>110</u> Length of drop pipe <u>65</u> ft. capacity <u>10</u> g.p.m. Type: <u>Submersible</u> <input checked="" type="checkbox"/> <u>Jet</u> <input type="checkbox"/> <u>Centrifugal</u> <input type="checkbox"/> <input type="checkbox"/> Submersible <input type="checkbox"/> Turbine <input checked="" type="checkbox"/> Jet <input type="checkbox"/> Reciprocating <input type="checkbox"/> Centrifugal <input type="checkbox"/> Other		
18. Elevation:		19. Remarks: <u>Concrete Slab to be installed by customer at surface of ground 4x4 slab and well house</u>				
Topography: <input checked="" type="checkbox"/> Hill <input checked="" type="checkbox"/> Slope <input type="checkbox"/> Upland <input type="checkbox"/> Valley		20. Water well contractor's certification: This well was drilled under my jurisdiction and this report is true to the best of my knowledge and belief. <u>Urban Well Service</u> License No. <u>226</u> Business name <u>Nashville Kansas</u> Address <u>Leavenworth</u> Signed <u>Leon G. Webb</u> Date <u>10 21 77</u> Authorized representative				