


1 LOCATION OF WATER WELL: Fraction SE 1/4 SE 1/4 NE 1/4 Section Number 13 Township Number 18 Range Number 9
 County: CHASE COUNTY

Distance and direction from nearest town or city street address of well if located within city?

2 WATER WELL OWNER: MIRIAM DIGGS
70 MEIER HENCKY REAL ESTATE
 RR #, St. Address, Box #: 2336 S.W. MAYFAIR PL Board of Agriculture, Division of Water Resources
 City, State, ZIP Code: TOPEKA KS 66611 Application Number: _____

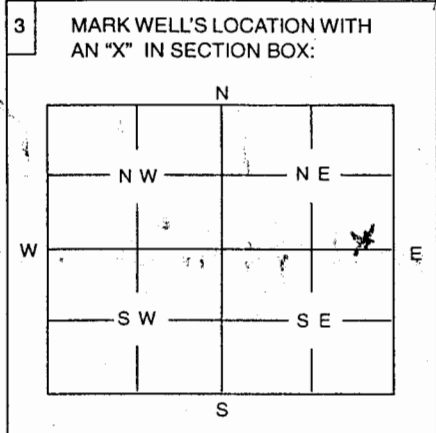

4 DEPTH OF WELL 42 ft
 WELL'S STATIC WATER LEVEL 21 ft.
 WELL WAS USED AS:
 1 Domestic 5 Public Water Supply 9 Dewatering
 2 Irrigation 6 Oil Field Water Supply 10 Monitoring Well
 3 Feedlot 7 Domestic (Lawn & Garden) 11 Injection Well
 4 Industrial 8 Air Conditioning 12 Other Closest Street

Was a chemical / bacteriological sample submitted to Department? Yes No X

If yes, mo/day/yr sample was submitted

Water Well Disinfected: Yes X No

5 TYPE OF BLANK CASING USED:
 1 Steel 3 RMP (SR) 5 Wrought 7 Fiberglass 9 Other (Specify below)
 2 PVC 4 ABS 6 Asbestos-Cement 8 Concrete Tile STONE

Blank casing diameter 3.6 in. Was casing pulled? Yes X No If yes, how much 5-6 FT

Casing height above or below land surface N/A in.

6 GROUT PLUG MATERIAL: 1 Neat cement 2 Cement grout 3 Bentonite 4 Other

Grout Plug Intervals: From ft. to ft., From ft. to ft., From to ft.

What is the nearest source of possible contamination: NONE

1 Septic tank 6 Seepage pit 11 Fuel storage 16 Other (specify below)
 2 Sewer lines 7 Pit privy 12 Fertilizer storage
 3 Watertight sewer lines 8 Sewage lagoon 13 Insecticide storage
 4 Lateral lines 9 Feedyard 14 Abandoned water well
 5 Cess Pool 10 Livestock pens 15 Oil well/Gas well

Direction from well? How many feet?

FROM	TO	PLUGGING MATERIALS
42	21	Rock SAND - CHLOROX
21	5	Clay Subsoil
5		BENTONITE
5	+1.5	Dirt Top Soil

RECEIVED
 OCT 08 2004
 BUREAU OF WATER

7 CONTRACTOR'S OR LANDOWNER'S CERTIFICATION: This water well was plugged under my jurisdiction and was completed on (mo/day/year) SEPT 21, 2004 and this record is true to the best of my knowledge and belief. Kansas Water Well Contractor's License No. 112 This Water Well Record was completed on (mo/day/year) SEPT 21, 2004 under the business name of MEIER HENCKY REAL ESTATE by (signature) Paul Meierhencky - Manager

INSTRUCTIONS: Use typewriter or ball point pen. Please press firmly and print clearly. Please fill in blanks, underline or circle the correct answers. Send top three copies to Kansas Department of Health and Environment, Bureau of Water, Topeka, Kansas 66620-0001. Telephone: 785/296-3565. Send one to Water Well Owner and retain one for your records.