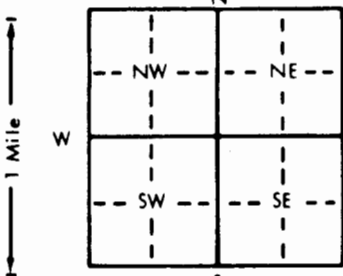


1 LOCATION OF WATER WELL:	Fraction	Section Number	Township Number	Range Number
County: Sedgwick	SE 1/4 SE 1/4 SW 1/4	4	T 29 S	R 1 E/W

Distance and direction from nearest town or city street address of well if located within city?
Approximately 1/2 mile south and 1/2 mile east of Bayneville

2 WATER WELL OWNER:	John W. Dugan	Board of Agriculture, Division of Water Resources
RR#, St. Address, Box # :	Route 1 - Box 37	Application Number:
City, State, ZIP Code :	Clearwater, KS 67026	

3 LOCATE WELL'S LOCATION WITH AN "X" IN SECTION BOX:	4 DEPTH OF COMPLETED WELL: 110 ft. ELEVATION: unknown
	Depth(s) Groundwater Encountered 1. ft. 2. ft. 3. ft.
	WELL'S STATIC WATER LEVEL Not ch'd ft. below land surface measured on mo/day/yr
	Pump test data: Well water was Not ch'd ft. after hours pumping gpm
	Est. Yield unknown gpm: Well water was ft. after hours pumping gpm
	Bore Hole Diameter . . . 5 . . . in. to . . . 115 . . . ft., and in. to ft.
WELL WATER TO BE USED AS: 5 Public water supply 8 Air conditioning 11 Injection well	
1 Domestic 3 Feedlot 6 Oil field water supply 9 Dewatering 12 Other (Specify below)	
2 Irrigation 4 Industrial 7 Lawn and garden only 10 Monitoring well Observation well	
Was a chemical/bacteriological sample submitted to Department? Yes No X If yes, mo/day/yr sample was submitted	
Water Well Disinfected? Yes X No	

5 TYPE OF BLANK CASING USED:	5 Wrought iron	8 Concrete tile	CASING JOINTS: Glued X Clamped
1 Steel	3 RMP (SR)	6 Asbestos-Cement	9 Other (specify below)
2 PVC	4 ABS	7 Fiberglass	Welded
Blank casing diameter 2 . . . in. to . . . 98 . . . ft., Dia in. to ft., Dia in. to ft.			Threaded
Casing height above land surface 24 . . . in., weight 70 . . . lbs./ft. Wall thickness or gauge No. 154			
TYPE OF SCREEN OR PERFORATION MATERIAL:		7 PVC	10 Asbestos-cement
1 Steel	3 Stainless steel	5 Fiberglass	8 RMP (SR)
2 Brass	4 Galvanized steel	6 Concrete tile	9 ABS
SCREEN OR PERFORATION OPENINGS ARE:		5 Gauzed wrapped	8 Saw cut
1 Continuous slot	3 Mill slot	6 Wire wrapped	9 Drilled holes
2 Louvered shutter	4 Key punched	7 Torch cut	10 Other (specify)
SCREEN-PERFORATED INTERVALS: From 98 . . . ft. to . . . 108 . . . ft., From ft. to ft.			11 None (open hole)
GRAVEL PACK INTERVALS: From 20 . . . ft. to . . . 80 . . . ft., From ft. to ft.			
From 84 . . . ft. to . . . 108 . . . ft., From ft. to ft.			

6 GROUT MATERIAL:	1 Neat cement	2 Cement grout	3 Bentonite	4 Other	Bentonite Holeplug
Grout Intervals: From ft. to ft., From 0 . . . ft. to . . . 20 . . . ft., From 80 . . . ft. to . . . 84 . . . ft.					
What is the nearest source of possible contamination:			10 Livestock pens	14 Abandoned water well	
1 Septic tank	4 Lateral lines	7 Pit privy	11 Fuel storage	15 Oil well/Gas well	
2 Sewer lines	5 Cess pool	8 Sewage lagoon	12 Fertilizer storage	16 Other (specify below)	
3 Watertight sewer lines	6 Seepage pit	9 Feedyard	13 Insecticide storage	None known	
Direction from well?			How many feet?		

FROM	TO	LITHOLOGIC LOG	FROM	TO	PLUGGING INTERVALS
0	4	Topsoil			
4	6	Clay, black			
6	11	Clay, gray, hard			
11	16	Clay, white, hard			
16	22	Sand and gravel, medium and fine, clean, loose			
22	36	Clay, brown, hard			
36	54	Clay, white, hard			
54	55	Sand and gravel, medium and fine, loose, clean			
55	84	Clay, white, hard			
84	108	Sand and gravel, medium and fine, loose, clean			
108	112	Clay, green, hard			
112	115	Shale, black, hard			

7 CONTRACTOR'S OR LANDOWNER'S CERTIFICATION: This water well was (1) constructed, (2) reconstructed, or (3) plugged under my jurisdiction and was completed on (mo/day/year) 3-25-96 and this record is true to the best of my knowledge and belief. Kansas Water Well Contractor's License No. 185 This Water Well Record was completed on (mo/day/yr) 6-26-96 under the business name of Clarke Well & Equipment, Inc. by (signature)
