


1 LOCATION OF WATER WELL: Sedgwick	FRACTION SE 1/4 SE 1/4 SW 1/4	Section Number 23	Township Number T 29 S	Range Number R 1W E/W
--	---	-----------------------------	----------------------------------	---------------------------------

Distance and direction from nearest town or city street address of well if located within city?
Hoover & West St. on 103rd, N. side Clearwater, Kansas

WATER WELL OWNER: **PHELPS, Donnie**
 RR#, ST. ADDRESS, BOX #: **4808 W. 103rd**
 CITY, STATE, ZIP CODE: **Clearwater, Kansas**

Board of Agriculture, Division of Water Resource
Application Number:

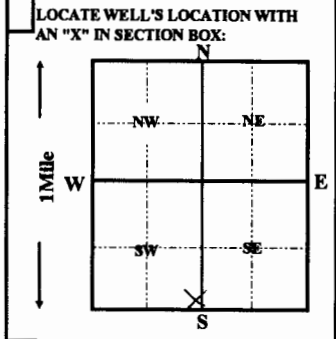

4 DEPTH OF COMPLETED WELL **62** ft. ELEVATION:

Depth(s) groundwater Encountered **1** ft. **2** ft. **3** ft.

WELL'S STATIC WATER LEVEL **20** FT. BELOW LAND SURFACE MEASURED ON **10/22/1999**
 Pump test data: Well water was _____ ft. after _____ hours pumping _____ gpm
 Est. Yield gpm: Well water was _____ ft. after _____ hours pumping _____ gpm

Bore Hole Diameter **12** in. to **62** ft. and _____ in. to _____ ft.

WELL WATER TO BE USED AS:

5 Public water supply	8 Air conditioning	11 Injection well
1 Domestic	3 Feedlot	6 Oil field water supply
2 Irrigation	4 Industrial	7 Lawn and garden only
		9 Dewatering
		10 Monitoring well
		12 Other (Specify below)

Was a chemical/bacteriological sample submitted to Department? Yes _____ No ; If yes, mo/day/yr sample was submitted _____

Water Well Disinfected? Yes No _____

5 TYPE OF CASING USED:

1 Steel	3 RMP (SR)	5 Wrought iron	8 Concrete tile	CASING JOINTS:	Glued <input checked="" type="checkbox"/>	Clamped
2 PVC	4 ABS	6 Asbestos-Cement	9 Other (Specify below)		Welded	
		7 Fiberglass	SDR-26		Threaded	

Blank casing Diameter **5** in. to **42** ft., Dia _____ in. to _____ ft.
 Casing height above land surface **12** in., weight **2.35** lbs. / ft. Wall thickness or gauge No. **.214**

TYPE OF SCREEN OR PERFORATION MATERIAL:

1 Steel	3 Stainless Steel	5 Fiberglass	8 RMP (SR)	10 Asbestos-cement
2 Brass	4 Galvanized steel	6 Concrete tile	9 ABS	11 other (specify)
				12 None used (open hole)

SCREEN OR PERFORATION OPENING ARE:

1 Continuous slot	3 Mill slot	5 Gauzed wrapped	8 Saw cut	11 None (open hole)
2 Louvered shutter	4 Key punched	6 Wire wrapped	9 Drilled holes	
		7 Torch cut	10 Other (specify)	

SCREEN-PERFORATION INTERVALS: from **42** ft. to **62** ft., From _____ ft. to _____ ft.
 GRAVEL PACK INTERVALS: from **26** ft. to **62** ft., From _____ ft. to _____ ft.

6 GROUT MATERIAL: 1 Neat cement 2 Cement grout 3 Bentonite 4 Other **bentonite hole plug**

Grout Intervals: From **4** ft. to **24** ft. From _____ ft. to _____ ft.

What is the nearest source of possible contamination:

1 Septic tank	4 Lateral lines	7 Pit privy	10 Livestock pens	14 Abandon water well
2 Sewer lines	5 Cess pool	8 Sewage lagoon	11 Fuel storage	15 Oil well/Gas well
3 Watertight sewer lines	6 Seepage pit	9 Feedyard	12 Fertilizer storage	16 Other (specify below)
			13 Insecticide storage	None Apparent

Direction from well? _____ How many feet? _____

FROM	TO	LITHOLOGIC LOG	FROM	TO	PLUGGING INTERVALS
0	4	topsoil			
4	30	clay			
30	38	medium sand			
38	62	shale			

7 CONTRACTOR'S OR LANDOWNER'S CERTIFICATION: This water well was (1) constructed, (2) reconstructed, or (3) plugged under my jurisdiction and was completed on (mo/day/year) **10/22/1999** and this record is true to the best of my knowledge and belief. Kansas Water Well Contractor's License No. **236** This Water Well Record was completed on (mo/day/yr) **10/25/99**

Under the business name of **Harp Well & Pump Service, Inc.** by (signature) *Todd S. Harp*