USE TYPEWRITER OR BALL POINT PEN-PRESS FIRMLY, PRINT CLEARLY.

WATER WELL RECORD
KSA 82a-1201-1215

Kansas Department of Health and Environment-Division of Environment
(Water well Contractors)
Topeka, Kansas 66620

1. Location of well: County: SEDGWICK | Fraction: 1/4 NE 1/4 NE 1/4 | Section number: 3 | Township number: T 29 S | Range number: R 1 E (W)

2. Distance and direction from nearest town or city: 5915 WEST 73RD So.
Street address of well location if in city: WICHITA, KANSAS

3. Owner of well: M. W. BRILEY
R.R. or street: 5915 WEST 73RD SOUTH
City, state, zip code: WICHITA, KANSAS

4. Locate with "X" in section below:

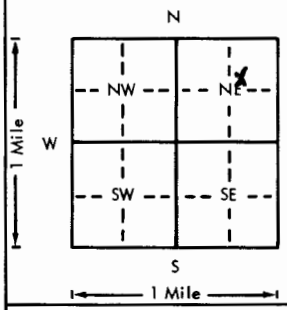

Sketch map:

6. Bore hole dia. 11 in. Completion date 9-30-76
Well depth 60 ft.

7. __ Cable tool ✓ Rotary __ Driven __ Dug
__ Hollow rod __ Jetted __ Bored __ Reverse rotary

8. Use: ✓ Domestic __ Public supply __ Industry
__ Irrigation __ Air conditioning __ Stock
__ Lawn __ Oil field water __ Other

9. Casing: Material STEEL | Height: Above or below
Threaded __ Welded ✓ | Surface 12 in.
RMP ✓ PVC __ | Weight __ lbs./ft.
Dia. 5 in. to 60 ft. depth | Wall Thickness: inches or
Dia. __ in. to __ ft. depth | gage No. 1200

5. Type and color of material	From	To
SANDY SOIL	0	3
CLAY	3	8
FINE SAND	8	30
MEDIUM SAND	30	60
(Use a second sheet if needed)		

10. Screen: Manufacturer's name SUNFLOWER PLASTIC
Type STYRENE Dia. 5"
Slot/gauze 106 Length 10'
Set between 50 ft. and 60 ft.
ft. and ft.
Gravel pack? YES Size range of material 1/4 - 1/8"

11. Static water level: mo./day/yr.
25 ft. below land surface Date 9-30-76

12. Pumping level below land surfaces:
ft. after hrs. pumping g.p.m.
ft. after hrs. pumping g.p.m.
Estimated maximum yield g.p.m.

13. Water sample submitted: mo./day/yr.
__ Yes __ No Date

14. Well head completion: CAPPED
__ Pitless adapter 12 Inches above grade

15. Well grouted? YES
With: __ Neat cement __ Bentonite ✓ Concrete
Depth: From 40" ft. to 14 ft.

16. Nearest source of possible contamination: SEPTIC
ft. 100 Direction SOUTH Type TANK
*Well disinfected upon completion? ✓ Yes __ No

17. Pump: ✓ Not installed
Manufacturer's name
Model number HP Volts
Length of drop pipe ft. capacity g.p.m.
Type:
__ Submersible __ Turbine
__ Jet __ Reciprocating
__ Centrifugal __ Other

18. Elevation:
Topography:
__ Hill
__ Slope
__ Upland
__ Valley

19. Remarks: FLAT GROUND

20. Water well contractor's certification:
This well was drilled under my jurisdiction and this report is true to the best of my knowledge and belief.
Business name HARP Well + Pump License No. 236
Address WICHITA KANSAS
Signed M. Arnold Authorized representative Date 10-29-76

Forward the white, blue and pink copies to the Department of Health and Environment

Form WWC-5

MI-1023

T 29 R 1 (W) E Sec 3 1/4 1/4 1/4 NE NE