USE TYPEWRITER OR BALL POINT PEN-PRESS FIRMLY, PRINT CLEARLY.

WATER WELL RECORD
KSA 82a-1201-1215

Kansas Department of Health and Environment-Division of Environment
(Water well Contractors)
Topeka, Kansas 66620

1. Location of well:	County: Sedgwick	Fraction: SE 1/4 SW 1/4 SW 1/4	Section number: 10	Township number: T 29 S	Range number: R 1 E (W)

2. Distance and direction from nearest town or city: 23th W. 1 So. Peck Ks.
Street address of well location if in city:

3. Owner of well: 2 St Electric
R.R. or street: 512 W. 2 St No.
City, state, zip code: Wichita Ks 67204

4. Locate with "X" in section below:

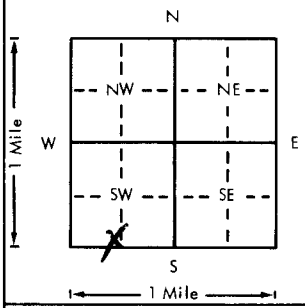

Sketch map:

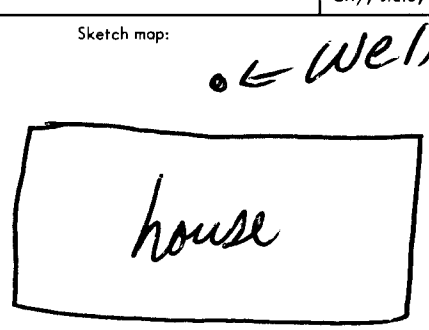

6. Bore hole dia. 11 in. Completion date
Well depth 50 ft. 5/30/78

7. __ Cable tool X Rotary __ Driven __ Dug
__ Hollow rod __ Jetted __ Bored __ Reverse rotary

8. Use: X Domestic __ Public supply __ Industry
__ Irrigation __ Air conditioning __ Stock
__ Lawn __ Oil field water __ Other

9. Casing: Material: Styrene Weight (Above) or below
Threaded ___ Welded X Surface 12 in.
RMP X PVC ___ Weight 1.50 lbs./ft.
Dia. 5 in. to 50 ft. depth Wall Thickness: inches or
Dia. ___ in. to ___ ft. depth gage No. 1200

10. Screen: Manufacturer's name Sunflower
Type 200 Dia. 5 in.
Slot/gauze 1/16 Length 8 ft.
Set between 42 ft. and 50 ft.
___ ft. and ___ ft.
Gravel pack? yes Size range of material 3/8

11. Static water level:
25 ft. below land surface Date 5/30/78 mo./day/yr.

12. Pumping level below land surfaces:
28 ft. after 1/2 hrs. pumping 12 g.p.m.
___ ft. after ___ hrs. pumping ___ g.p.m.
Estimated maximum yield 20 g.p.m.

13. Water sample submitted: mo./day/yr.
___ Yes X No Date

14. Well head completion:
___ Pitless adapter 12 Inches above grade

15. Well grouted? yes
With: ___ Neat cement ___ Bentonite X Concrete
Depth: From 3 ft. to 13 ft.

16. Nearest source of possible contamination:
ft 300 Direction So. Type River
Well disinfected upon completion? X Yes ___ No

17. Pump: X Not installed
Manufacturer's name
Model number HP Volts
Length of drop pipe ft. capacity g.p.m.
Type:
___ Submersible ___ Turbine
___ Jet ___ Reciprocating
___ Centrifugal ___ Other

5. Type and color of material

From	To
Top Soil	0	2
Red clay.	2	12
fine sand.	12	40
Charcoal shale.	40	50

(Use a second sheet if needed)

18. Elevation:
Topography:
X Hill
___ Slope
___ Uplond
___ Valley

19. Remarks: Customer to furnish 4x4x4" slab around casing at grade per State Regulations
Signed X J. Harris

20. Water well contractor's certification:
This well was drilled under my jurisdiction and this report is true to the best of my knowledge and belief.
Wenger Drilling 318
Business name License No.
Address Wichita
Signature Authorized Representative Date 6/1/78

Forward the white, blue and pink copies to the Department of Health and Environment.

Form WWC-5

29 T 1 R E (W) 10 Sec SE SW SW 1/4 1/4 1/4

MI-1023