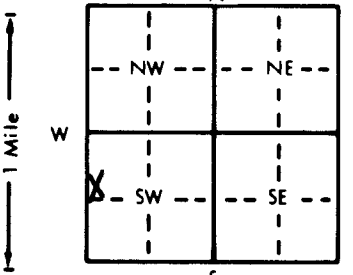


1 LOCATION OF WATER WELL: County: <u>Sedgwick</u>		Fraction <u>SW</u> $\frac{1}{4}$ <u>NW</u> $\frac{1}{4}$ <u>SW</u> $\frac{1}{4}$		Section Number <u>10</u>	Township Number <u>T 29 S</u>	Range Number <u>R 1W E/W</u>
Distance and direction from nearest town or city street address of well if located within city? <u>8500 S. Ridge Road Wichita, Kansas</u>						
2 WATER WELL OWNER: <u>Strunk, Nick</u> RR#, St. Address, Box #: <u>8500 S. Ridge Rd.</u> City, State, ZIP Code: <u>Wichita, Kansas</u> Board of Agriculture, Division of Water Resources Application Number: _____						
3 LOCATE WELL'S LOCATION WITH AN "X" IN SECTION BOX: 		4 DEPTH OF COMPLETED WELL: <u>90</u> ft. ELEVATION: _____ Depth(s) Groundwater Encountered 1. <u>35</u> ft. 2. _____ ft. 3. _____ ft. WELL'S STATIC WATER LEVEL _____ ft. below land surface measured on <u>mo/day/yr</u> <u>8-14-91</u> Pump test data: Well water was _____ ft. after _____ hours pumping _____ gpm Est. Yield _____ gpm: Well water was _____ ft. after _____ hours pumping _____ gpm Bore Hole Diameter <u>11</u> in. to <u>90</u> ft., and _____ in. to _____ ft. WELL WATER TO BE USED AS: 5 Public water supply 8 Air conditioning 11 Injection well 1 Domestic 3 Feedlot 6 Oil field water supply 9 Dewatering 12 Other (Specify below) 2 Irrigation 4 Industrial 7 Lawn and garden only 10 Monitoring well Was a chemical/bacteriological sample submitted to Department? Yes _____ No <u>X</u> ; If yes, mo/day/yr sample was submitted _____ Water Well Disinfected? Yes <u>X</u> No _____				
5 TYPE OF BLANK CASING USED: 1 Steel 3 RMP (SR) 5 Wrought iron 8 Concrete tile CASING JOINTS: Glued <u>X</u> Clamped _____ <u>2 PVC</u> 4 ABS 6 Asbestos-Cement 9 Other (specify below) Welded _____ Blank casing diameter <u>5</u> in. to <u>70</u> ft., Dia _____ in. to _____ ft., Dia _____ in. to _____ ft. Casing height above land surface <u>12</u> in., weight <u>2.29</u> lbs./ft. Wall thickness or gauge No. <u>214</u> TYPE OF SCREEN OR PERFORATION MATERIAL: <u>7 PVC</u> 10 Asbestos-cement 1 Steel 3 Stainless steel 5 Fiberglass 8 RMP (SR) 11 Other (specify) _____ 2 Brass 4 Galvanized steel 6 Concrete tile 9 ABS 12 None used (open hole) SCREEN OR PERFORATION OPENINGS ARE: 5 Gauzed wrapped <u>8 Saw cut</u> 11 None (open hole) 1 Continuous slot 3 Mill slot 6 Wire wrapped 9 Drilled holes 2 Louvered shutter 4 Key punched 7 Torch cut 10 Other (specify) _____ SCREEN-PERFORATED INTERVALS: From <u>70</u> ft. to <u>90</u> ft., From _____ ft. to _____ ft. From _____ ft. to _____ ft., From _____ ft. to _____ ft. GRAVEL PACK INTERVALS: From <u>24</u> ft. to <u>90</u> ft., From _____ ft. to _____ ft. From _____ ft. to _____ ft., From _____ ft. to _____ ft.						
6 GROUT MATERIAL: 1 Neat cement 2 Cement grout 3 Bentonite 4 Other _____ Grout Intervals: From <u>4</u> ft. to <u>24</u> ft., From _____ ft. to _____ ft., From _____ ft. to _____ ft. What is the nearest source of possible contamination: 1 Septic tank 4 Lateral lines 7 Pit privy 10 Livestock pens 14 Abandoned water well 2 Sewer lines 5 Cess pool 8 Sewage lagoon 11 Fuel storage 15 Oil well/Gas well 3 Watertight sewer lines 6 Seepage pit 9 Feedyard 12 Fertilizer storage 16 Other (specify below) 13 Insecticide storage <u>None Apparent</u> Direction from well? _____ How many feet? _____						
FROM	TO	LITHOLOGIC LOG	FROM	TO	PLUGGING INTERVALS	
0	3	topsoil				
3	38	clay				
38	43	fine sand				
43	61	clay				
61	64	fine sand				
64	73	clay				
73	82	fine sand				
82	90	grey shale				
7 CONTRACTOR'S OR LANDOWNER'S CERTIFICATION: This water well was (1) constructed, (2) reconstructed, or (3) plugged under my jurisdiction and was completed on (mo/day/year) <u>8-14-91</u> and this record is true to the best of my knowledge and belief. Kansas Water Well Contractor's License No. <u>236</u> This Water Well Record was completed on (mo/day/yr) <u>12-2-91</u> under the business name of <u>Harp Well and Pump Service, Inc.</u> by (signature) <u>Mary Arnold</u>						
INSTRUCTIONS: Use typewriter or ball point pen. PLEASE PRESS FIRMLY and PRINT clearly. Please fill in blanks, underline or circle the correct answers. Send top three copies to Kansas Department of Health and Environment, Bureau of Water, Topeka, Kansas 66620-0001. Telephone: 913-296-5545. Send one to WATER WELL OWNER and retain one for your records.						