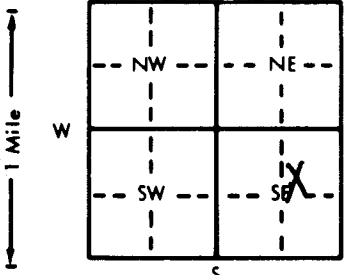


5" Test Well for Well #9

WATER WELL RECORD

Form WWC-5

KSA 82a-1212

1 LOCATION OF WATER WELL:		Fraction SW 1/4 NE 1/4 SE 1/4	Section Number 11	Township Number T 29 S	Range Number R 1 W E/W
Distance and direction from nearest town or city street address of well if located within city? The 5" Test well will be 100' E & 1213' S of NW Corner, E _{1/2} , SE _{1/4} , Sec. 11, T29S-R1W					
2 WATER WELL OWNER:		City of Haysville			
RR#, St. Address, Box # :		Haysville, KS.			
City, State, ZIP Code :		Board of Agriculture, Division of Water Resources Application Number:			
3 LOCATE WELL'S LOCATION WITH AN "X" IN SECTION BOX:		4 DEPTH OF COMPLETED WELL: 78 ft. ELEVATION:			
		Depth(s) Groundwater Encountered 1. ft. 2. ft. 3. ft.			
		WELL'S STATIC WATER LEVEL ... 30'6" ... ft. below land surface measured on mo/day/yr			
		Pump test data: Well water was ft. after hours pumping gpm			
		Est. Yield gpm: Well water was ft. after hours pumping gpm			
		Bore Hole Diameter ... 11 ... in. to ft., and in. to ft.			
5 TYPE OF BLANK CASING USED:		CASING JOINTS: Glued Clamped			
1 Steel		3 RMP (SR)		Welded ... Metal	
2 PVC		4 ABS		Threaded ... Screw	
Blank casing diameter 5 ... in. to 48 ... ft., Dia. in. to ft., Dia. in. to ft.		6 Asbestos-Cement			
Casing height above land surface 18 ... in., weight 1.59 ... lbs./ft. Wall thickness or gauge No. 203		7 Fiberglass			
TYPE OF SCREEN OR PERFORATION MATERIAL:		8 Concrete tile			
1 Steel		3 Stainless steel		5 Fiberglass	
2 Brass		4 Galvanized steel		6 Concrete tile	
SCREEN OR PERFORATION OPENINGS ARE:		7 PVC			
1 Continuous slot		3 Mill slot		8 RMP (SR)	
2 Louvered shutter		4 Key punched		9 ABS	
SCREEN-PERFORATED INTERVALS:		10 Asbestos-cement			
From 48 ... ft. to 78 ... ft., From ft. to ft.		11 Other (specify)			
GRAVEL PACK INTERVALS:		12 None used (open hole)			
From 32 ... ft. to 78 ... ft., From ft. to ft.		5 Gauzed wrapped			
From ft. to ft., From ft. to ft.		8 Saw cut			
From ft. to ft., From ft. to ft.		11 None (open hole)			
6 GROUT MATERIAL:		4 Other			
1 Neat cement		2 Cement grout		3 Bentonite	
Grout Intervals: From 0 ... ft. to 32 ... ft., From ft. to ft., From ft. to ft.		4 Other			
What is the nearest source of possible contamination:		10 Livestock pens			
1 Septic tank		4 Lateral lines		14 Abandoned water well	
2 Sewer lines		5 Cess pool		15 Oil well/Gas well	
3 Watertight sewer lines		6 Seepage pit		16 Other (specify below)	
9 Feedyard		13 Insecticide storage			
Direction from well?		How many feet?			
FROM TO LITHOLOGIC LOG FROM TO PLUGGING INTERVALS					
0 2 Topsoil					
2 6 Brown Clay					
6 12 Tan Clay					
12 19 Fine to Coarse Sand, Fine to Medium Gravel					
19 23 Coarse Sand to Coarse Gravel					
31 32 Clay					
32 35 Very Fine to Fine Sand					
35 52 Fine to Coarse Sand, Fine to Coarse Gravel					
52 64 Gray Clay					
64 78 Very Fine to Fine Sand to Coarse Sand					
78 Yellow Shale					
7 CONTRACTOR'S OR LANDOWNER'S CERTIFICATION: This water well was (1) constructed, (2) reconstructed, or (3) plugged under my jurisdiction and was completed on (mo/day/year) 5-16-88 and this record is true to the best of my knowledge and belief. Kansas					
Water Well Contractor's License No. 236 This Water Well Record was completed on (mo/day/yr) 6-7-88					
under the business name of Harp Well & Pump Service, Inc. by (signature) Mary Arnold					
INSTRUCTIONS: Use typewriter or ball point pen. PLEASE PRESS FIRMLY and PRINT clearly. Please fill in blanks, underline or circle the correct answers. Send top three copies to Kansas Department of Health and Environment, Bureau of Water Protection, Topeka, Kansas 66620-7320. Telephone: 913-296-5514. Send one to WATER WELL OWNER and retain one for your records.					