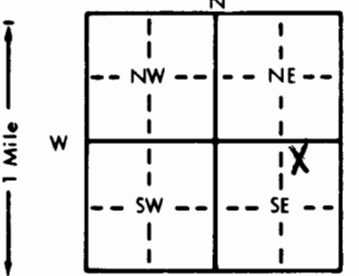


5" Test Well for Well #8

WATER, WELL RECORD

Form WWC-5

KSA 82a-1212

1 LOCATION OF WATER WELL:		Fraction	Section Number	Township Number	Range Number
County: SEDGWICK		NW 1/4 NE 1/4 SE 1/4	11	T 29 S	R 1 W E/W
Distance and direction from nearest town or city street address of well if located within city?					
The 5" Test well will be 100' E & 120' S of the NW corner, E 1/2, SE 1/4, Sec. 11, T29S-R1W.					
2 WATER WELL OWNER:		City of Haysville			
RR#, St. Address, Box # :		Haysville, KS.			
City, State, ZIP Code :		Board of Agriculture, Division of Water Resources Application Number:			
3 LOCATE WELL'S LOCATION WITH AN "X" IN SECTION BOX:		4 DEPTH OF COMPLETED WELL: 70 ft. ELEVATION:			
		Depth(s) Groundwater Encountered 1. 32' 5" ft. 2. ft. 3. ft.			
		WELL'S STATIC WATER LEVEL 32' 5" ft. below land surface measured on mo/day/yr 5-16-88.			
		Pump test data: Well water was ft. after hours pumping gpm			
		Est. Yield gpm: Well water was ft. after hours pumping gpm			
		Bore Hole Diameter 11 in. to ft., and in. to ft.			
		WELL WATER TO BE USED AS: 5 Public water supply 8 Air conditioning 11 Injection well			
		1 Domestic 3 Feedlot 6 Oil field water supply 9 Dewatering 12 Other (Specify below)			
		2 Irrigation 4 Industrial 7 Lawn and garden only 10 Monitoring well Test Well			
		Was a chemical/bacteriological sample submitted to Department? Yes No XX; If yes, mo/day/yr sample was submitted			
		Water Well Disinfected? Yes No XX			
5 TYPE OF BLANK CASING USED:		CASING JOINTS: Glued Clamped			
1 Steel 3 RMP (SR)		Welded Metal			
2 PVC 4 ABS		Threaded Screws			
Blank casing diameter 5 in. to 50 ft., Dia		Cer-Mac styrene SDR-26			
Casing height above land surface 18 in., weight 1.59 lbs./ft.		Wall thickness or gauge No. 203			
TYPE OF SCREEN OR PERFORATION MATERIAL:		7 PVC 10 Asbestos-cement			
1 Steel 3 Stainless steel 5 Fiberglass 8 RMP (SR) 11 Other (specify)		12 None used (open hole)			
2 Brass 4 Galvanized steel 6 Concrete tile 9 ABS					
SCREEN OR PERFORATION OPENINGS ARE:		5 Gauzed wrapped 8 Saw cut 11 None (open hole)			
1 Continuous slot 3 Mill slot 6 Wire wrapped 9 Drilled holes					
2 Louvered shutter 4 Key punched 7 Torch cut 10 Other (specify)					
SCREEN-PERFORATED INTERVALS: From 50 ft. to 70 ft., From ft. to ft.					
GRAVEL PACK INTERVALS: From 20 ft. to 70 ft., From ft. to ft.					
6 GROUT MATERIAL: 1 Neat cement 2 Cement grout 3 Bentonite 4 Other					
Grout Intervals: From 0 ft. to 20 ft., From ft. to ft.					
What is the nearest source of possible contamination:		10 Livestock pens 14 Abandoned water well			
1 Septic tank 4 Lateral lines 7 Pit privy 11 Fuel storage 15 Oil well/Gas well		12 Fertilizer storage 16 Other (specify below)			
2 Sewer lines 5 Cess pool 8 Sewage lagoon 13 Insecticide storage None apparent					
3 Watertight sewer lines 6 Seepage pit 9 Feedyard					
Direction from well?		How many feet?			
FROM	TO	LITHOLOGIC LOG	FROM	TO	PLUGGING INTERVALS
0	2	Topsoil			
2	5	Blue Clay			
5	10	Tan Clay			
10	26	Fine to Coarse Sand, Fine to Medium Gravel			
26	35	Very Fine to Coarse Sand to Fine Gravel			
35	36	Tan Clay			
36	56	Very Fine to Coarse Sand to Fine Gravel			
56	70	Very Fine to Fine Sand to Fine Gravel			
70		Yellow Shale			
7 CONTRACTOR'S OR LANDOWNER'S CERTIFICATION: This water well was (1) constructed, (2) reconstructed, or (3) plugged under my jurisdiction and was completed on (mo/day/year) 5-16-88 and this record is true to the best of my knowledge and belief Kansas					
Water Well Contractor's License No. 236 This Water Well Record was completed on (mo/day/yr) 6-7-88					
under the business name of Harp Well & Pump Service, Inc. by (signature) Mary Arnold					
INSTRUCTIONS: Use typewriter or ball point pen. PLEASE PRESS FIRMLY and PRINT clearly. Please fill in blanks, underline or circle the correct answers. Send top three copies to Kansas Department of Health and Environment, Bureau of Water Protection, Topeka, Kansas 66620-7320. Telephone: 913-296-5514. Send one to WATER WELL OWNER and retain one for your records.					