


WATER WELL RECORD Form WWC-5 KSA 82a-1212

1 LOCATION OF WATER WELL: County: Sedgwick Fraction: NW 1/4 NW 1/4 NW 1/4 Section Number: 26 Township Number: T 29 S Range Number: R 1W E/W

Distance and direction from nearest town or city street address of well if located within city?  
1/8 S. of 103rd S. and 55th West. Eastside Wichita, Ks.

2 WATER WELL OWNER: Rod Rink  
 RR#, St. Address, Box # : 2223 S. Market Board of Agriculture, Division of Water Resources  
 City, State, ZIP Code : Wichita, Ks. Application Number:

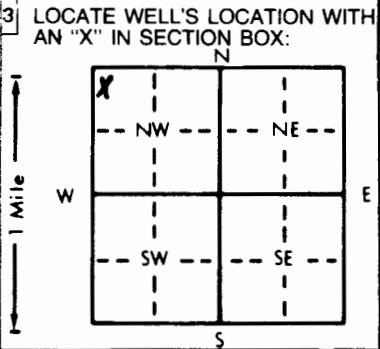

4 DEPTH OF COMPLETED WELL: 65 ft. ELEVATION:  
 Depth(s) Groundwater Encountered 1. 25 ft. 2. \_\_\_\_\_ ft. 3. \_\_\_\_\_ ft.  
 WELL'S STATIC WATER LEVEL: 25 ft. below land surface measured on mo/day/yr 5-8-90  
 Pump test data: Well water was \_\_\_\_\_ ft. after \_\_\_\_\_ hours pumping \_\_\_\_\_ gpm  
 Est. Yield \_\_\_\_\_ gpm Well water was \_\_\_\_\_ ft. after \_\_\_\_\_ hours pumping \_\_\_\_\_ gpm  
 Bore Hole Diameter: 11 in. to \_\_\_\_\_ ft. and \_\_\_\_\_ in. to \_\_\_\_\_ ft.  
 WELL WATER TO BE USED AS:  
 1 Domestic \_\_\_\_\_ 2 Irrigation \_\_\_\_\_ 3 Feedlot \_\_\_\_\_ 4 Industrial \_\_\_\_\_  
 5 Public water supply \_\_\_\_\_ 6 Oil field water supply \_\_\_\_\_ 7 Lawn and garden only \_\_\_\_\_  
 8 Air conditioning \_\_\_\_\_ 9 Dewatering \_\_\_\_\_ 10 Monitoring well \_\_\_\_\_  
 11 Injection well \_\_\_\_\_ 12 Other (Specify below) \_\_\_\_\_  
 Was a chemical/bacteriological sample submitted to Department? Yes \_\_\_\_\_ No X \_\_\_\_\_; If yes, mo/day/yr sample was submitted \_\_\_\_\_  
 Water Well Disinfected? Yes X No \_\_\_\_\_

5 TYPE OF CASING USED:  
 1 Steel \_\_\_\_\_ 2 PVC 160 3 RMP (SR) \_\_\_\_\_ 4 ABS \_\_\_\_\_  
 5 Wrought iron \_\_\_\_\_ 6 Asbestos-Cement \_\_\_\_\_ 7 Fiberglass \_\_\_\_\_  
 8 Concrete tile \_\_\_\_\_ 9 Other (specify below) SDR-26  
 Blank casing diameter \_\_\_\_\_ in. to \_\_\_\_\_ in. Dia \_\_\_\_\_ ft., Dia \_\_\_\_\_ in. to \_\_\_\_\_ ft.  
 Casing height above land surface \_\_\_\_\_ in., weight \_\_\_\_\_ lbs./ft. Wall thickness or gauge No. .214

TYPE OF SCREEN OR PERFORATION MATERIAL:  
 1 Steel \_\_\_\_\_ 2 Brass \_\_\_\_\_ 3 Stainless steel \_\_\_\_\_ 4 Galvanized steel \_\_\_\_\_  
 5 Fiberglass \_\_\_\_\_ 6 Concrete tile \_\_\_\_\_ 7 PVC \_\_\_\_\_ 8 RMP (SR) \_\_\_\_\_  
 10 Asbestos-cement \_\_\_\_\_ 11 Other (specify) \_\_\_\_\_ 12 None used (open hole) \_\_\_\_\_  
 SCREEN OR PERFORATION OPENINGS ARE:  
 1 Continuous slot \_\_\_\_\_ 2 Louvered shutter \_\_\_\_\_ 3 Mill slot \_\_\_\_\_ 4 Key punched \_\_\_\_\_  
 5 Gauzed wrapped \_\_\_\_\_ 6 Wire wrapped \_\_\_\_\_ 7 Torch cut \_\_\_\_\_ 8 Saw cut \_\_\_\_\_  
 9 Drilled holes \_\_\_\_\_ 10 Other (specify) \_\_\_\_\_ 11 None (open hole) \_\_\_\_\_  
 SCREEN-PERFORATED INTERVALS: From \_\_\_\_\_ ft. to \_\_\_\_\_ ft. From \_\_\_\_\_ ft. to \_\_\_\_\_ ft.  
 GRAVEL PACK INTERVALS: From \_\_\_\_\_ ft. to \_\_\_\_\_ ft. From \_\_\_\_\_ ft. to \_\_\_\_\_ ft.

6 GROUT MATERIAL: 1 Neat cement \_\_\_\_\_ 2 Cement grout \_\_\_\_\_ 3 Bentonite \_\_\_\_\_ 4 Other \_\_\_\_\_  
 Grout Intervals: From \_\_\_\_\_ ft. to \_\_\_\_\_ ft. From \_\_\_\_\_ ft. to \_\_\_\_\_ ft. From \_\_\_\_\_ ft. to \_\_\_\_\_ ft.  
 What is the nearest source of possible contamination:  
 1 Septic tank \_\_\_\_\_ 2 Sewer lines \_\_\_\_\_ 3 Watertight sewer lines \_\_\_\_\_ 4 Lateral lines \_\_\_\_\_ 5 Cess pool \_\_\_\_\_ 6 Seepage pit \_\_\_\_\_  
 7 Pit privy \_\_\_\_\_ 8 Sewage lagoon \_\_\_\_\_ 9 Feedyard \_\_\_\_\_ 10 Livestock pens \_\_\_\_\_ 11 Fuel storage \_\_\_\_\_ 12 Fertilizer storage \_\_\_\_\_  
 13 Insecticide storage \_\_\_\_\_ 14 Abandoned water well \_\_\_\_\_ 15 Oil well/Gas well \_\_\_\_\_ 16 Other (specify below) \_\_\_\_\_  
 Direction from well? \_\_\_\_\_ How many feet? None Apparent

FROM	TO	LITHOLOGIC LOG	FROM	TO	PLUGGING INTERVALS
0	3	topsoil			
3	28	clay			
28	50	fine sand			
50	53	clay			
53	65	medium sand			

7 CONTRACTOR'S OR LANDOWNER'S CERTIFICATION: This water well was (1) constructed, (2) reconstructed, or (3) plugged under my jurisdiction and was completed on (mo/day/year) 5-8-90 and this record is true to the best of my knowledge and belief. Kansas Water Well Contractor's License No. 236 This Water Well Record was completed on (mo/day/yr) 5-31-90 under the business name of Harp Well and Pump Service, Inc. by (signature) Mary Arnold