USE TYPEWRITER OR BALL POINT PEN-PRESS FIRMLY, PRINT CLEARLY.

WATER WELL RECORD
KSA 82a-1201-1215

Kansas Department of Health and Environment-Division of Environment
(Water well Contractors)
Topeka, Kansas 66620

| 1. Location of well: | County | Fraction | Section number | Township number | Range number |
|---|---|---|---|---|---|
| | SEDGWICK | 1/4 SE 1/4 SW 1/4 | 34 | T 29 S | R 1W E/W |

2. Distance and direction from nearest town or city: ½ E. of Ridge Rd. on 119th S. on the N. side of the road. Peck, Kansas

Street address of well location if in city:

3. Owner of well: Leonard Schmeissner
R.R. or street: R.R. #1
City, state, zip code: Peck, Kansas

4. Locate with "X" in section below:

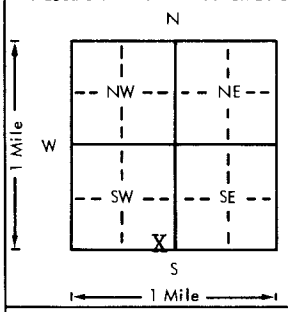


Sketch map:

6. Bore hole dia. 11 in. Completion date
Well depth 45 ft. 7-18-78

7. __ Cable tool X Rotary __ Driven __ Dug
__ Hollow rod __ Jetted __ Bored __ Reverse rotary

8. Use: X Domestic __ Public supply __ Industry
__ Irrigation __ Air conditioning __ Stock
__ Lown __ Oil field water __ Other

9. Casing: Material Styrene Height: Above or ~~below~~
Threaded __ Welded gl Surface 12 in.
RMP X PVC __ Weight __ lbs./ft.
Dia. 5 in. to 45 ft. depth Wall Thickness: inches or
Dia. __ in. to __ ft. depth gage No. .200

| 5. Type and color of material | From | To |
|---|---|---|
| Topsoil | 0 | 3 |
| Clay | 3 | 12 |
| Fine Sand | 12 | 35 |
| Gray Shale | 35 | 45 |

(Use a second sheet if needed)

10. Screen: Manufacturer's name Sunflower Plastic
Type styrene Dia. 5"
Slot/~~gap~~ .06 Length 15'
Set between 30 ft. and 45 ft.
__ ft. and __ ft.
Gravel pack? yes Size range of material ¼-1/8"

11. Static water level: mo./day/yr.
15 ft. below land surface Date 7-18-78

12. Pumping level below land surfaces:
__ ft. after __ hrs. pumping __ g.p.m.
__ ft. after __ hrs. pumping __ g.p.m.
Estimated maximum yield __ g.p.m.

13. Water sample submitted: mo./day/yr.
__ Yes __ No Date

14. Well head completion: capped
__ Pitless adapter 12 Inches above grade

15. Well grouted? yes 1-2Fine Sand Mix
With: __ Neat cement __ Bentonite X Concrete
Depth: From 40" ft. to 14 ft.

16. Nearest source of possible contamination: Septic
ft. 55 Direction South Type Tank
Well disinfected upon completion? X Yes __ No

17. Pump: X Not installed
Manufacturer's name
Model number HP Volts
Length of drop pipe ft. copocity g.p.m.
Type:
__ Submersible __ Turbine
__ Jet __ Reciprocating
__ Centrifugal __ Other

18. Elevotion:

Topography:
__ Hill
__ Slope
__ Upland
__ Valley

19. Remarks: Flat Ground

20. Water well contractor's certification:
This well was drilled under my jurisdiction and this report is true to the best of my knowledge and belief.
Harp Well & Pump 236
Business name License No.
Address Wichita, Kansas 67209
Signed M. Arnold Date 8-2-78
Authorized representative

T 29 R 1 (E) W Sec 34 1/4 SE 1/4 1/4

Forward the white, blue and pink copies to the Department of Health and Environment

Form WWC-5

MI-1023