

Plugging Report


1 LOCATION OF WATER WELL: County: Seelye Fraction: SE 1/4 SE 1/4 SE 1/4 Section Number: 11 Township Number: T 29 S Range Number: R 1 E

Distance and direction from nearest town or city street address of well if located within city?

8715 S. West St.

2 WATER WELL OWNER: Mr Cook Board of Agriculture, Division of Water Resources
RR#, St. Address, Box #: 8715 S. West St. Application Number: none
City, State, ZIP Code: Haysville Kansas 67060

3 LOCATE WELL'S LOCATION WITH AN "X" IN SECTION BOX: DEPTH OF COMPLETED WELL: 55 ft. ELEVATION: 1300

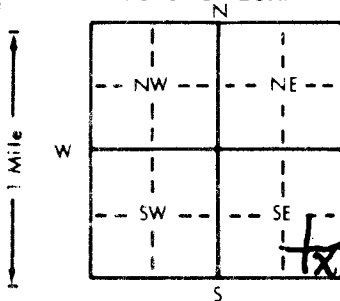

Depth(s) Groundwater Encountered: 32 ft. 2. 32 ft. 3. 11-8-94

WELL'S STATIC WATER LEVEL: 32 ft. below land surface measured on mo/day/yr

Pump test data: Well water was _____ ft. after _____ hours pumping _____ gpm

Est. Yield _____ gpm: Well water was _____ ft. after _____ hours pumping _____ gpm

Bore Hole Diameter: 4 in. to _____ ft. and _____ in. to _____ ft.

WELL WATER TO BE USED AS: 5 Public water supply 8 Air conditioning 11 Injection well

1 Domestic 3 Feedlot 6 Oil field water supply 9 Dewatering 12 Other (Specify below)

2 Irrigation 4 Industrial 7 Lawn and garden only 10 Monitoring well

Was a chemical/bacteriological sample submitted to Department? Yes _____ No X; If yes, mo/day/yr sample was sub-

mitted Water Well Disinfected? Yes _____ No X

5 TYPE OF BLANK CASING USED: 5 Wrought iron 8 Concrete tile CASING JOINTS: Glued _____ Clamped _____

1 Steel 3 RMP (SR) Welded _____

2 PVC 4 ABS Threaded X

Blank casing diameter: 5 in. to _____ ft. Dia _____ in. to _____ ft. Dia _____ in. to _____ ft.

Casing height above land surface: 32 in., weight _____ lbs. ft. Wall thickness or gauge No. _____

TYPE OF SCREEN OR PERFORATION MATERIAL: 7 PVC 10 Asbestos-cement

1 Steel 3 Stainless steel 8 RMP (SR) 11 Other (specify) NA

2 Brass 4 Galvanized steel 9 ABS 12 None used (open hole)

SCREEN OR PERFORATION OPENINGS ARE: 5 Gauzed wrapped 8 Saw cut 11 None (open hole)

1 Continuous slot 3 Mill slot 6 Wire wrapped 9 Drilled holes

2 Louvered shutter 4 Key punched 7 Torch cut 10 Other (specify) NA

SCREEN-PERFORATED INTERVALS: From _____ ft. to _____ ft. From _____ ft. to _____ ft.

From _____ ft. to _____ ft. From _____ ft. to _____ ft.

GRAVEL PACK INTERVALS: From _____ ft. to _____ ft. From _____ ft. to _____ ft.

From _____ ft. to _____ ft. From _____ ft. to _____ ft.

6 GROUT MATERIAL: 1 Neat cement 2 Cement grout 3 Bentonite 4 Other

Grout intervals: From 20 ft. to 0 ft. From _____ ft. to _____ ft. From _____ ft. to _____ ft.

What is the nearest source of possible contamination: 10 Livestock pens 14 Abandoned water well

1 Septic tank 4 Lateral lines 7 Pit privy 11 Fuel storage 15 Oil well/Gas well

2 Sewer lines 5 Cess pool 8 Sewage lagoon 12 Fertilizer storage 16 Other (specify below)

3 Watertight sewer lines 6 Seepage pit 9 Feedyard 13 Insecticide storage

Direction from well? West How many feet? 25

FROM TO LITHOLOGIC LOG FROM TO PLUGGING INTERVALS

55 20 Gravel Fill 55 20

20 3 Cement grout 20 3

3 0 Fill Dirt 3 0

7 CONTRACTOR'S OR LANDOWNER'S CERTIFICATION: This water well was (1) constructed, (2) reconstructed, or (3) plugged under my jurisdiction and was completed on (mo/day/year) 11-8-94 and this record is true to the best of my knowledge and belief. Kansas

Water Well Contractor's License No. 472 This Water Well Record was completed on (mo/day/yr) 11-8-94

under the business name of Borden Pump & Well Serv (signature) David R Babb