


1 LOCATION OF WATER WELL: Fraction $\frac{1}{4}$ C NE $\frac{1}{4}$ NW $\frac{1}{4}$ Section Number 3 Township Number T 29 S Range Number R 10 EW

Distance and direction from nearest town or city street address of well if located within city?
 65 13/8 E 1/8 S OF CUNNINGHAM, KS

2 WATER WELL OWNER: H-30 Drilling Company
 RR#, St. Address, Box #: Wichita, Kansas
 City, State, ZIP Code: Lease: Albers G #1 Application Number: 83-687
 Board of Agriculture, Division of Water Resources

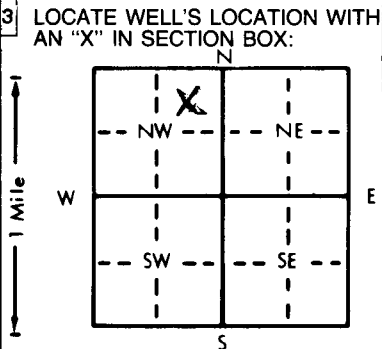

4 DEPTH OF COMPLETED WELL: 80 ft. ELEVATION: ...
 Depth(s) Groundwater Encountered 1. 60 ft. 2. ... ft. 3. ... ft.
 WELL'S STATIC WATER LEVEL: 60 ft. below land surface measured on mo/day/yr 15 Nov. 83
 Pump test data: Well water was ... ft. after ... hours pumping ... gpm
 Est. Yield 100 gpm: Well water was ... ft. after ... hours pumping ... gpm
 Bore Hole Diameter 10 in. to 80 ft., and ... in. to ... ft.
 WELL WATER TO BE USED AS:
 1 Domestic 3 Feedlot 6 Oil field water supply 9 Dewatering 12 Other (Specify below)
 2 Irrigation 4 Industrial 7 Lawn and garden only 10 Observation well
 Was a chemical/bacteriological sample submitted to Department? Yes ... No X; If yes, mo/day/yr sample was submitted
 Water Well Disinfected? Yes X No

5 TYPE OF BLANK CASING USED:
 1 Steel 3 RMP (SR) 5 Wrought iron 8 Concrete tile CASING JOINTS: Glued X Clamped ...
 2 PVC 4 ABS 6 Asbestos-Cement 9 Other (specify below) Welded ...
 7 Fiberglass Threaded ...
 Blank casing diameter 5 in. to 60 ft., Dia in. to ... ft., Dia in. to ... ft.
 Casing height above land surface 12 in., weight ... lbs./ft. Wall thickness or gauge No. 2.14
 TYPE OF SCREEN OR PERFORATION MATERIAL:
 1 Steel 3 Stainless steel 5 Fiberglass 7 PVC 10 Asbestos-cement
 2 Brass 4 Galvanized steel 6 Concrete tile 8 RMP (SR) 11 Other (specify) ...
 9 ABS 12 None used (open hole)
 SCREEN OR PERFORATION OPENINGS ARE:
 1 Continuous slot 3 Mill slot 5 Gauzed wrapped 8 Saw cut 11 None (open hole)
 2 Louvered shutter 4 Key punched 6 Wire wrapped 9 Drilled holes
 7 Torch cut 10 Other (specify) ...
 SCREEN-PERFORATED INTERVALS: From 60 ft. to 80 ft., From ... ft. to ... ft.
 GRAVEL PACK INTERVALS: From 10 ft. to 80 ft., From ... ft. to ... ft.

6 GROUT MATERIAL: 1 Neat cement 2 Cement grout 3 Bentonite 4 Other ...
 Grout intervals: From 0 ft. to 10 ft., From ... ft. to ... ft., From ... ft. to ... ft.
 What is the nearest source of possible contamination:
 1 Septic tank 4 Lateral lines 7 Pit privy 11 Fuel storage 14 Abandoned water well
 2 Sewer lines 5 Cess pool 8 Sewage lagoon 12 Fertilizer storage 15 Oil well/Gas well
 3 Watertight sewer lines 6 Seepage pit 9 Feedyard 13 Insecticide storage 16 Other (specify below)
 Direction from well? How many feet? NONE

FROM	TO	LITHOLOGIC LOG	FROM	TO	LITHOLOGIC LOG
0	3	Top soil			
3	30	Clay, gray			
30	40	Clay, tan			
40	55	Sand, fine to coarse			
55	60	Clay, gray			
60	80	Sand, fine to coarse and med to coarse gravel			

7 CONTRACTOR'S OR LANDOWNER'S CERTIFICATION: This water well was (1) constructed, (2) reconstructed, or (3) plugged under my jurisdiction and was completed on (mo/day/year) 15 NOV 83 and this record is true to the best of my knowledge and belief. Kansas Water Well Contractor's License No. 325 This Water Well Record was completed on (mo/day/yr) 14 FEB 84 under the business name of Central Well & Pump Inc. by (signature) J. J. Anonick

INSTRUCTIONS: Use typewriter or ball point pen, PLEASE PRESS FIRMLY and PRINT clearly. Please fill in blanks, underline or circle the correct answers. Send top three copies to Kansas Department of Health and Environment, Division of Environment, Environmental Geology Section, Topeka, KS 66620. Send one to WATER WELL OWNER and retain one for your records.

OFFICE USE ONLY

T

29

R

10

EW

SEC

3

C

1/4

NE

1/4

21/4