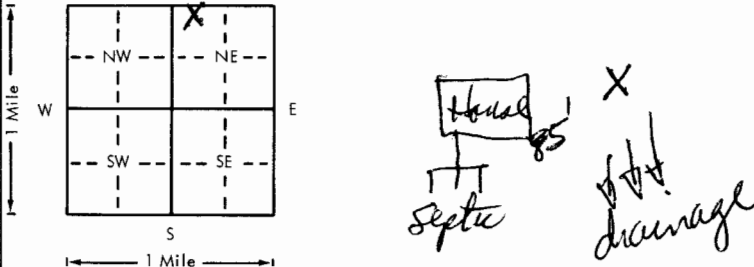


USE TYPEWRITER OR BALL  
POINT PEN-PRESS FIRMLY,  
PRINT CLEARLY.

WATER WELL RECORD  
KSA 82a-1201-1215

Kansas Department of Health and  
Environment-Division of Environment  
(Water well Contractors)  
Topeka, Kansas 66620

1. Location of well:		County <b>KINGMAN</b>	Fraction <b>NW 1/4 NW 1/4 NE 1/4</b>	Section number <b>28</b>	Township number <b>T 29 S R 10 W</b>	Range number <b>E/W</b>
2. Distance and direction from nearest town or city: Street address of well location if in city:		<b>4 N &amp; 3/4 E of Nashville</b>		3. Owner of well: <b>Herman Frischer</b> R.R. or street: City, state, zip code: <b>Nashville, Ks</b>		
4. Locate with "X" in section below: N 1 Mile W E S 1 Mile		Sketch map: 		6. Bore hole dia. <b>10</b> in. Completion date <b>16 Aug 77</b> Well depth <b>75</b> ft.		
5. Type and color of material		From	To	7. <input checked="" type="checkbox"/> Cable tool <input checked="" type="checkbox"/> Rotary <input type="checkbox"/> Driven <input type="checkbox"/> Dug <input type="checkbox"/> Hollow rod <input type="checkbox"/> Jetted <input type="checkbox"/> Bored <input type="checkbox"/> Reverse rotary		
Soil		0	2	8. Use: <input checked="" type="checkbox"/> Domestic <input type="checkbox"/> Public supply <input type="checkbox"/> Industry <input type="checkbox"/> Irrigation <input type="checkbox"/> Air conditioning <input type="checkbox"/> Stock <input type="checkbox"/> Lawn <input type="checkbox"/> Oil field water <input type="checkbox"/> Other		
Sand, silt		2	4	9. Casing: Material <input type="checkbox"/> Height: Above or below Threaded <input type="checkbox"/> Welded <input type="checkbox"/> Surface <b>12</b> in. RMP <input checked="" type="checkbox"/> PVC <input type="checkbox"/> Weight <input type="checkbox"/> lbs./ft. Dia. <b>5</b> in. to <b>65</b> ft. depth Wall Thickness: inches or Dia. <input type="checkbox"/> in. to <input type="checkbox"/> ft. depth gage No. <b>200</b>		
Clay, white		4	21	10. Screen: Manufacturer's name <b>JAL</b> Type <b>Saw slot</b> Dia. <b>5</b> Slot/gauze <b>1/8</b> Length <b>10'</b> Set between <b>65</b> ft. and <b>75</b> ft. ft. and <input type="checkbox"/> ft. Gravel pack? <input checked="" type="checkbox"/> Size range of material <b>4x4</b>		
Clay, yellow		21	45	11. Static water level: <input type="checkbox"/> mo./day/yr. <b>47.5</b> ft. below land surface Date <b>16 Aug 77</b>		
Sand, fine to medium		45	51	12. Pumping level below land surfaces: <input type="checkbox"/> ft. after <input type="checkbox"/> hrs. pumping <input type="checkbox"/> g.p.m. <input type="checkbox"/> ft. after <input type="checkbox"/> hrs. pumping <input type="checkbox"/> g.p.m. Estimated maximum yield <b>30</b> g.p.m.		
Sand, fine to coarse and med. gravel		51	75	13. Water sample submitted: <input type="checkbox"/> mo./day/yr. <input type="checkbox"/> Yes <input checked="" type="checkbox"/> No Date <input type="checkbox"/>		
Clay, multi colored		75	90	14. Well head completion: <input checked="" type="checkbox"/> Pitless adapter <b>12</b> Inches above grade		
				15. Well grouted? <input checked="" type="checkbox"/> With: <input checked="" type="checkbox"/> Neat cement <input type="checkbox"/> Bentonite <input type="checkbox"/> Concrete Depth: From <b>4</b> ft. to <b>14</b> ft.		
				16. Nearest source of possible contamination: ft. <b>85</b> Direction <b>SW</b> Type <b>Septic</b> Well disinfected upon completion? <input checked="" type="checkbox"/> Yes <input type="checkbox"/> No		
				17. Pump: <input checked="" type="checkbox"/> Not installed Manufacturer's name <input type="checkbox"/> Model number <input type="checkbox"/> HP <input type="checkbox"/> Volts <input type="checkbox"/> Length of drop pipe <input type="checkbox"/> ft. capacity <input type="checkbox"/> g.p.m. Type: <input type="checkbox"/> Submersible <input type="checkbox"/> Turbine <input type="checkbox"/> Jet <input type="checkbox"/> Reciprocating <input type="checkbox"/> Centrifugal <input type="checkbox"/> Other		
18. Elevation:		(Use a second sheet if needed)		20. Water well contractor's certification: This well was drilled under my jurisdiction and this report is true to the best of my knowledge and belief. <b>Central Well &amp; Pump Svc. 325</b> Business name License No. Address <b>121 S. Taylor Pratt, Ks.</b> Signed <b>Edgarovich</b> Date <b>22 July 78</b> Authorized representative		
19. Remarks: <b>4'x4'x4" Slab below Pitless Adapter</b>				21. Topography: <input type="checkbox"/> Hill <input type="checkbox"/> Slope <input checked="" type="checkbox"/> Upland <input type="checkbox"/> Valley		