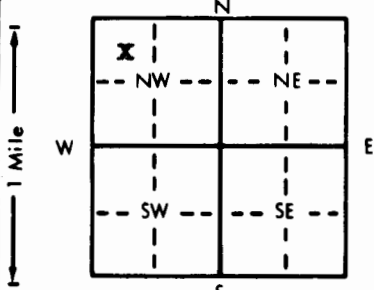


1 LOCATION OF WATER WELL: County: Kingman Fraction: NW 1/4 SW 1/4 NW 1/4 Section Number: 28 Township Number: T 29 S Range Number: R 10 EW

Distance and direction from nearest town or city street address of well if located within city?
334 N Nashville

2 WATER WELL OWNER: Gary Adelhardt
 RR#, St. Address, Box #: Nashville, Kansas 67112
 City, State, ZIP Code: _____
 Board of Agriculture, Division of Water Resources
 Application Number: _____

3 LOCATE WELL'S LOCATION WITH AN "X" IN SECTION BOX:

 4 DEPTH OF COMPLETED WELL: 72 ft. ELEVATION: 40 ft.
 Depth(s) Groundwater Encountered 1. 33 ft. 2. _____ ft. 3. _____ ft.
 WELL'S STATIC WATER LEVEL: 33 ft. below land surface measured on mo/day/yr 12-21-87
 Pump test data: Well water was _____ ft. after _____ hours pumping _____ gpm
 Est. Yield: 15 gpm: Well water was _____ ft. after _____ hours pumping _____ gpm
 Bore Hole Diameter: 9 in. to 72 in. to _____ in. to _____ in.
 WELL WATER TO BE USED AS:
 1 Domestic _____ 3 Feedlot _____ 5 Public water supply _____ 8 Air conditioning _____ 11 Injection well _____
 2 Irrigation _____ 4 Industrial _____ 6 Oil field water supply _____ 9 Dewatering _____ 12 Other (Specify below) _____
 7 Lawn and garden only _____ 10 Observation well _____
 Was a chemical/bacteriological sample submitted to Department? Yes: NO; If yes, mo/day/yr sample was submitted _____
 Water Well Disinfected? Yes _____ No _____

5 TYPE OF BLANK CASING USED:
 1 Steel _____ 3 RMP (SR) _____ 5 Wrought iron _____ 8 Concrete tile _____ CASING JOINTS: Clamped _____ Clamped _____
 2 PVC _____ 4 ABS _____ 6 Asbestos-Cement _____ 9 Other (specify below) _____ Welded _____
 7 Fiberglass _____ Threaded _____
 Blank casing diameter: 5 in. to 28 in. Dia. 5 from 48 to 72 in. Dia. _____ in. to _____ in. ft.
 Casing height above land surface: 20 in. weight _____ lbs./ft. Wall thickness or gauge No. .214
 TYPE OF SCREEN OR PERFORATION MATERIAL:
 1 Steel _____ 3 Stainless steel _____ 5 Fiberglass _____ 7 PVC _____ 10 Asbestos-cement _____
 2 Brass _____ 4 Galvanized steel _____ 6 Concrete tile _____ 8 RMP (SR) _____ 11 Other (specify) _____
 9 ABS _____ 12 None used (open hole) _____
 SCREEN OR PERFORATION OPENINGS ARE:
 1 Continuous slot _____ 3 Mill slot _____ 5 Gauzed wrapped _____ 8 Saw cut _____ 11 None (open hole) _____
 2 Louvered shutter _____ 4 Key punched _____ 6 Wire wrapped _____ 9 Drilled holes _____
 7 Torch cut _____ 10 Other (specify) _____
 SCREEN-PERFORATED INTERVALS: From 28 ft. to 48 ft. From _____ ft. to _____ ft.
 From _____ ft. to _____ ft. From _____ ft. to _____ ft.
 GRAVEL PACK INTERVALS: From 20 ft. to 72 ft. From _____ ft. to _____ ft.
 From _____ ft. to _____ ft. From _____ ft. to _____ ft.

6 GROUT MATERIAL: 1 Neat cement _____ 2 Cement grout _____ 3 Bentonite _____ 4 Other _____
 Grout Intervals: From 20 ft. to 20 ft. From _____ ft. to _____ ft. From _____ ft. to _____ ft.
 What is the nearest source of possible contamination:
 1 Septic tank _____ 4 Lateral lines _____ 7 Pit privy _____ 10 Livestock pens _____ 14 Abandoned water well _____
 2 Sewer lines _____ 5 Cess pool _____ 8 Sewage lagoon _____ 11 Fuel storage _____ 15 Oil well/Gas well _____
 3 Watertight sewer lines _____ 6 Seepage pit _____ 9 Feedyard _____ 12 Fertilizer storage _____ 16 Other (specify below) _____
 13 Insecticide storage _____
 Direction from well? W How many feet? 100

FROM	TO	LITHOLOGIC LOG	FROM	TO	LITHOLOGIC LOG
0	2	soil			
2	7	sand			
7	18	clay			
18	28	fine sand			
28	32	coarse gravel			
32	54	fine sand & clay streaks			
54	72	clay			

7 CONTRACTOR'S OR LANDOWNER'S CERTIFICATION: This water well was (1) constructed, (2) reconstructed, or (3) plugged under my jurisdiction and was completed on (mo/day/year) 12-21-87 and this record is true to the best of my knowledge and belief. Kansas Water Well Contractor's License No. 140 This Water Well Record was completed on (mo/day/yr) 12-28-87 under the business name of Lyman Inc. by (signature) [Signature]

INSTRUCTIONS: Use typewriter or ball point pen. PLEASE PRESS FIRMLY and PRINT clearly. Please fill in blanks, underline or circle the correct answers. Send top three copies to Kansas Department of Health and Environment, Bureau of Water Protection, Topeka, Kansas 66620-7320, Telephone: 913-862-9360. Send one to WATER WELL OWNER and retain one for your records.