

**WATER WELL RECORD Form WWC-5**

Original Record  Correction  Change in Well Use

Division of Water Resources App. No.


Well ID

**1 LOCATION OF WATER WELL:** Fraction  Section Number  Township Number  Range Number

County: Kingman  $\frac{1}{4}$  NW  $\frac{1}{4}$  NW  $\frac{1}{4}$  NW  $\frac{1}{4}$  NW 16 T 29 S R 10 E  W

**2 WELL OWNER:** Last Name: Industrial Maintenance, Inc First: Wichita State: KS ZIP: 67214

Business: Industrial Maintenance, Inc Street or Rural Address where well is located (if unknown, distance and direction from nearest town or intersection): If at owner's address, check here:   
 Address: 708 E. 18th From St. Leo West 1 mile to Sw 170 Ave E  
 Address: Sw 80 St well is east of Sw 170 Ave @ 600 FT  
 City: Wichita & 300ft South of Sw 80 St.

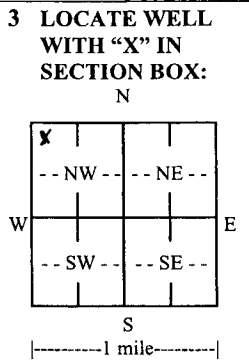

**4 DEPTH OF COMPLETED WELL:** 89 ft.

Depth(s) Groundwater Encountered: 1) 89 ft.  
 2)          ft. 3)          ft., or 4)  Dry Well

WELL'S STATIC WATER LEVEL: 5.7 ft.  
 below land surface, measured on (mo-day-yr) 4-30-20  
 above land surface, measured on (mo-day-yr)         

Pump test data: Well water was          ft.  
 after          hours pumping          gpm  
 Well water was          ft.  
 after          hours pumping          gpm

Estimated Yield:          gpm  
 Bore Hole Diameter: 10.58 in. to 90 ft. and          in. to          ft.

**5 Latitude:**          (decimal degrees)  
**Longitude:**          (decimal degrees)  
 Horizontal Datum:  WGS 84  NAD 83  NAD 27  
 Source for Latitude/Longitude:  
 GPS (unit make/model:         )  
 (WAAS enabled?  Yes  No)  
 Land Survey  Topographic Map  
 Online Mapper:         

**6 Elevation:**          ft.  Ground Level  TOC  
 Source:  Land Survey  GPS  Topographic Map  
 Other         

**7 WELL WATER TO BE USED AS:**

1. Domestic: <input checked="" type="checkbox"/> Household <input type="checkbox"/> Lawn & Garden <input type="checkbox"/> Livestock 2. <input type="checkbox"/> Irrigation 3. <input type="checkbox"/> Feedlot 4. <input type="checkbox"/> Industrial	5. <input type="checkbox"/> Public Water Supply: well ID <u>        </u> 6. <input type="checkbox"/> Dewatering: how many wells? <u>        </u> 7. <input type="checkbox"/> Aquifer Recharge: well ID <u>        </u> 8. <input type="checkbox"/> Monitoring: well ID <u>        </u> 9. Environmental Remediation: well ID <u>        </u> <input type="checkbox"/> Air Sparge <input type="checkbox"/> Soil Vapor Extraction <input type="checkbox"/> Recovery <input type="checkbox"/> Injection	10. <input type="checkbox"/> Oil Field Water Supply: lease <u>        </u> 11. Test Hole: well ID <u>        </u> <input type="checkbox"/> Cased <input type="checkbox"/> Uncased <input type="checkbox"/> Geotechnical 12. Geothermal: how many bores? <u>        </u> a) Closed Loop <input type="checkbox"/> Horizontal <input type="checkbox"/> Vertical b) Open Loop <input type="checkbox"/> Surface Discharge <input type="checkbox"/> Inj. of Water 13. <input type="checkbox"/> Other (specify): <u>        </u>
--	--	---

Was a chemical/bacteriological sample submitted to KDHE?  Yes  No If yes, date sample was submitted:           
 Water well disinfected?  Yes  No

**8 TYPE OF CASING USED:**  Steel  PVC  Other CASING JOINTS:  Glued  Clamped  Welded  Threaded

Casing diameter 5 in. to 6.9 ft., Diameter          in. to          ft., Diameter          in. to          ft.  
 Casing height above land surface 18 in. Weight SDR 26 lbs./ft. Wall thickness or gauge No.         

TYPE OF SCREEN OR PERFORATION MATERIAL:  
 Steel  Stainless Steel  Fiberglass  PVC  Other (Specify)           
 Brass  Galvanized Steel  Concrete tile  None used (open hole)

SCREEN OR PERFORATION OPENINGS ARE:  
 Continuous Slot  Mill Slot  Gauze Wrapped  Torch Cut  Drilled Holes  Other (Specify)           
 Louvered Shutter  Key Punched  Wire Wrapped  Saw Cut  None (Open Hole)

SCREEN-PERFORATED INTERVALS: From 6.9 ft. to 8.9 ft., From          ft. to          ft., From          ft. to          ft.  
 GRAVEL PACK INTERVALS: From 8.9 ft. to 4.5 ft., From 4.0 ft. to 2.5 ft., From          ft. to          ft.

**9 GROUT MATERIAL:**  Neat cement  Cement grout  Bentonite  Other         

Grout Intervals: From 2.5 ft. to 0 ft., From 4.0 ft. to 4.5 ft., From          ft. to          ft.

Nearest source of possible contamination:  
 Septic Tank  Lateral Lines  Pit Privy  Livestock Pens  Insecticide Storage  
 Sewer Lines  Cess Pool  Sewage Lagoon  Fuel Storage  Abandoned Water Well  
 Watertight Sewer Lines  Seepage Pit  Feedyard  Fertilizer Storage  Oil Well/Gas Well  
 Other (Specify)         

Direction from well? 999 Distance from well? 999 ft.

10 FROM	TO	LITHOLOGIC LOG	FROM	TO	LITHO. LOG (cont.) or PLUGGING INTERVALS
0	5	Dark Brn Sandy Top Soil			
5	30	White Clay			
30	40	Fine Tan Sand			
40	45	Sandy clay mix			
45	85	Fine Tan Sand			
85	90	Brn Clay			
					Notes:

**11 CONTRACTOR'S OR LANDOWNER'S CERTIFICATION:** This water well was  constructed,  reconstructed, or  plugged under my jurisdiction and was completed on (mo-day-year) 4-30-20 and this record is true to the best of my knowledge and belief. Kansas Water Well Contractor's License No. 672. This Water Well Record was completed on (mo-day-year) 5-12-20 under the business name of Crowd's Water Well Svc. Signature John Crowd

Mail 1 white copy along with a fee of \$5.00 for each constructed well to: Kansas Department of Health and Environment, Bureau of Water Section, 1000 SW Jackson St., Suite 420, Topeka, Kansas 66612-1367. Mail one to Water Well Owner and retain one for your records. Telephone 785-296-5524.  
 Visit us at <http://www.kdheks.gov/waterwell/index.html> KSA 82a-1212 Revised 7/10/2015