

1 LOCATION OF WATER WELL: County: Pratt	Fraction $\frac{1}{4}$ C $\frac{1}{4}$ NE $\frac{1}{4}$	Section Number 28	Township Number T 29 S	Range Number R 11 E W
---------------------------------------------------	--------------------------------------------------------------------------	-----------------------------	----------------------------------	----------------------------------------

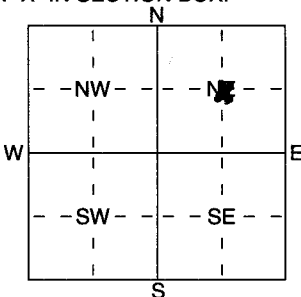
Distance and direction from nearest town or city street address of well if located within city?

From **Isabel, KS**: **1 mile East + 1 3/4 miles North**2 WATER WELL OWNER: **KS Dept of Wildlife**RR#, St. Address, Box #: **512 SE 25th Avenue**City, State, ZIP Code: **Pratt KS 67124-8174**

Board of Agriculture, Division of Water Resources

Application Number: **33,282**3 LOCATE WELL'S LOCATION WITH 4 DEPTH OF COMPLETED WELL **124** ft. ELEVATION:

AN "X" IN SECTION BOX:

Depth(s) Groundwater Encountered **53** ft. 2 ft. 3 ft.WELL'S STATIC WATER LEVEL **53** ft. below land surface measured on mo/day/yr **3-30-03**Pump test data: Well water was **37** ft. after **1.5** hours pumping **5.50** gpmEst. Yield **5.50** gpm: Well water was **80** ft. after **1.5** hours pumping **6.10** gpm

WELL WATER TO BE USED AS: 5 Public water supply 8 Air conditioning 11 Injection well

1 Domestic 3 Feedlot 6 Oil field water supply 9 Dewatering 12 Other (Specify below)

2 Irrigation 4 Industrial 7 Domestic (lawn & garden) 10 Monitoring well **pond**Was a chemical/bacteriological sample submitted to Department? Yes ☒ No ☒; If yes, mo/day/yr sample was submittedWater Well Disinfected? Yes ☒ No

5 TYPE OF BLANK CASING USED:

1 Steel 3 RMP (SR)

☒ PVC 4 ABS

5 Wrought iron

6 Asbestos-Cement

7 Fiberglass

8 Concrete tile

9 Other (specify below)

CASING JOINTS: Glued ☒ Clamped

Welded

Threaded

Blank casing diameter **16** in. to **84** ft., Dia **16** in. to **1/2"** ft.Casing height above land surface **36** in., weight **16** lbs./ft. Wall thickness or gauge No. **1/2"**

TYPE OF SCREEN OR PERFORATION MATERIAL:

1 Steel 3 Stainless Steel

2 Brass 4 Galvanized Steel

5 Fiberglass

6 Concrete tile

☒ PVC

8 RMP (SR)

9 ABS

10 Asbestos-Cement

11 Other (Specify)

12 None used (open hole)

SCREEN OR PERFORATION OPENINGS ARE:

1 Continuous slot

2 Louvered shutter

☒ Mill slot

4 Key punched

5 Gauzed wrapped

6 Wire wrapped

7 Torch cut

8 Saw cut

9 Drilled holes

10 Other (specify) ft.

11 None (open hole)

SCREEN-PERFORATED INTERVALS: From **84** ft. to **124** ft., From ft. to ft.

From ft. to ft., From ft. to ft.

GRAVEL PACK INTERVALS: From **20** ft. to **124** ft., From ft. to ft.

From ft. to ft., From ft. to ft.

6 GROUT MATERIAL:

1 Neat cement

☒ Cement grout

3 Bentonite

4 Other

Grout Intervals: From **2** ft. to **20** ft., From ft. to ft., From ft. to ft.

What is the nearest source of possible contamination:

1 Septic tank

2 Sewer lines

3 Watertight sewer lines

4 Lateral lines

5 Cess pool

6 Seepage pit

7 Pit privy

8 Sewage lagoon

9 Feedyard

10 Livestock pens

11 Fuel storage

12 Fertilizer storage

13 Insecticide storage

14 Abandoned water well

15 Oil well/Gas well

16 Other (specify below)

Direction from well? **West**How many feet? **200**

FROM	TO	LITHOLOGIC LOG	FROM	TO	PLUGGING INTERVALS
0	2	Top Soil			
2	15	Brown Clay			
15	23	Gray Clay			
23	33	White Clay + Lignite			
33	66	Brown + Tan Clays			
66	77	Very Fine to Coarse Sand			
77	81	Fine to Coarse Sand to Med Gravel			
81	84	Yellow Clay			
84	96	Very Fine to Coarse Sand			
96	108	Fine to Coarse Sand to Med Gravel			
108	112	Sandy Tan Clay			
112	120	Very Fine to Coarse Sand Silty			
120	124	Brown Clay			

7 CONTRACTOR'S OR LANDOWNER'S CERTIFICATION: This water well was ☒ constructed, (2) reconstructed, or (3) plugged under my jurisdiction and was completed on (mo/day/year) **3-26-03** and this record is true to the best of my knowledge and belief. KansasWater Well Contractor's Licence No **238** This Water Well Record was completed on (mo/day/yr) **4-12-03**under the business name of **Wendy Irrigation** by (signature) **Wendy**