


1	LOCATION OF WATER WELL:	Fraction	Section Number	Township Number	Range Number
County:	XX Pratt	SW $\frac{1}{4}$ SE $\frac{1}{4}$ SW $\frac{1}{4}$	31	T 29 S	R 11 XX ^{NE}

Distance and direction from nearest town or city street address of well if located within city?
6 East, 1 3/4 South of Sawyer

2 WATER WELL OWNER: CMX, Inc.
RR#, St. Address, Box # : 1551 N. Waterfront Pkwy.- Suite 150
City, State, ZIP Code : Wichita, Ks, 67206

3	LOCATE WELL'S LOCATION WITH	4	DEPTH OF COMPLETED WELL <u>135</u> ft. ELEVATION:
---	-----------------------------	---	---

AN "X" IN SECTION BOX: Depth(s) Groundwater Encountered 1 ft. 2 ft. 3 ft.

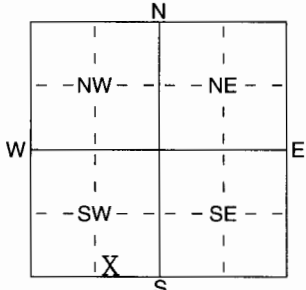

Depth(s) Groundwater Encountered 1 ft. 2 ft. 3 ft.
WELL'S STATIC WATER LEVEL 7.7 ft. below land surface measured on mo/day/yr 6-14-05 ft.
Pump test data: Well water was ft. after hours pumping gpm
Est. Yield N/A gpm Well water was ft. after hours pumping gpm
WELL WATER TO BE USED AS: 5 Public water supply 8 Air conditioning 11 Injection well
1 Domestic 3 Feedlot 6 Oil field water supply 9 Dewatering 12 Other (Specify below)
2 Irrigation 4 Industrial 7 Domestic (lawn & garden) 10 Monitoring well

Was a chemical/bacteriological sample submitted to Department? Yes No X; If yes, mo/day/yr sample was submitted
Water Well Disinfected? Yes HTH No

5	TYPE OF BLANK CASING USED:		5 Wrought iron	8 Concrete tile	CASING JOINTS: Glued <u>X</u> Clamped	
	1 Steel	3 RMP (SR)	6 Asbestos-Cement	9 Other (specify below)		Welded
	2 PVC	4 ABS	7 Fiberglass			Threaded

Blank casing diameter 5 in. to 115 ft. Dia in. to ft. Dia in. to ft.
Casing height above land surface 18 in., weight SDR-26 lbs./ft. Wall thickness or gauge No.

TYPE OF SCREEN OR PERFORATION MATERIAL:

1 Steel	3 Stainless Steel	5 Fiberglass	7 <u>PVC</u>	10 Asbestos-Cement
2 Brass	4 Galvanized Steel	6 Concrete tile	8 RMP (SR)	11 Other (Specify)
			9 ABS	12 None used (open hole)

SCREEN OR PERFORATION OPENINGS ARE:

1 Continuous slot	3 Mill slot	5 Guazed wrapped	8 <u>Saw cut</u>	11 None (open hole)
2 Louvered shutter	4 Kev punched	6 Wire wrapped	9 Drilled holes	
		7 Torch cut	10 Other (specify)	ft.

SCREEN-PERFORATED INTERVALS: From135..... ft. to115..... ft., From ft. to ft.
From ft. to ft., From ft. to ft.
GRAVEL PACK INTERVALS: From135..... ft. to20..... ft., From ft. to ft.
From ft. to ft. From ft. to ft.

6	GROUT MATERIAL:	1 Neat cement	2 Cement grout	3 Bentonite	4 Other.....hole plug.....
---	-----------------	---------------	----------------	-------------	----------------------------

Grout Intervals: From 10 ft. to 0 ft., From _____ ft. to _____ ft., From _____ ft. to _____ ft.

What is the nearest source of possible contamination:

1 Septic tank	4 Lateral lines	7 Pit privy	10 Livestock pens	14 Abandoned water well
2 Sewer lines	5 Cess pool	8 Sewage lagoon	11 Fuel storage	15 Oil well/Gas well
3 Watertight sewer lines	6 Seepage pit	9 Feedyard	12 Fertilizer storage	16 Other (specify below)
			13 Insecticide storage	None

Direction from well? _____ How many feet? _____

[illegible]

7. CONTRACTOR'S OR LANDOWNER'S CERTIFICATION: This water well was (1) constructed, (2) reconstructed, or (3) plugged under my jurisdiction and was completed on (mo/day/year) 6-14-05 and this record is true to the best of my knowledge and belief. Kansas Water Well Contractor's Licence No. 134 This Water Well Record was completed on (mo/day/yr) 6-17-05 under the business name of Rosencrantz- Bemis by (signature) [Signature]