

Site #45(3)

WATER WELL RECORD

Form WWC-5

KSA 82a-1212

1 LOCATION OF WATER WELL		Fraction NE 1/4 NE 1/4 SE 1/4		Section Number 1	Township Number T 29 S	Range Number R 11 E (W)	
County: Pratt				Distance and direction from nearest town or city? 5 mi E, 6 1/2 mi S of Cairo			
2 WATER WELL OWNER: KGS/GWMD#5				Street address of well if located within city?			
RR#, St. Address, Box # : City, State, ZIP Code :				Board of Agriculture, Division of Water Resources Application Number:			
3 DEPTH OF COMPLETED WELL 90 ft. Bore Hole Diameter 9-7/8 in. to 90 ft., and in. to ft.							
Well Water to be used as: 1 Domestic 3 Feedlot 5 Public water supply 8 Air conditioning 11 Injection well 2 Irrigation 4 Industrial 6 Oil field water supply 9 Dewatering 12 Other (Specify below) 7 Lawn and garden only 10 Observation well							
Well's static water level 46.1 ft. below land surface measured on January month 27 day 1983 year							
Pump Test Data Est. Yield gpm: Well water was ft. after hours pumping gpm Well water was ft. after hours pumping gpm							
4 TYPE OF BLANK CASING USED: 1 Steel 3 RMP (SR) 5 Wrought iron 8 Concrete tile Casing Joints: Glued 2 Clamped 2 PVC 4 ABS 6 Asbestos-Cement 9 Other (specify below) Welded 7 Fiberglass Threaded							
Blank casing dia 5 in. to 85 ft., Dia in. to ft., Dia in. to ft.							
Casing height above land surface 12 in., weight lbs./ft. Wall thickness or gauge No SDR 21							
TYPE OF SCREEN OR PERFORATION MATERIAL: 1 Steel 3 Stainless steel 5 Fiberglass 8 RMP (SR) 10 Asbestos-cement 2 Brass 4 Galvanized steel 6 Concrete tile 9 ABS 11 Other (specify) 12 None used (open hole)							
Screen or Perforation Openings Are: 1 Continuous slot 3 Mill slot 5 Gauzed wrapped 8 Saw cut 11 None (open hole) 2 Louvered shutter 4 Key punched 6 Wire wrapped 9 Drilled holes 7 Torch cut 10 Other (specify)							
Screen-Perforation Dia 5 in. to 90 ft., Dia in. to ft., Dia in. to ft.							
Screen-Perforated Intervals: From 85 ft. to 90 ft., From ft. to ft. to ft. to ft.							
Gravel Pack Intervals: From Formation ft. to ft., From ft. to ft. to ft. to ft.							
5 GROUT MATERIAL: 1 Neat cement 2 Cement grout 3 Bentonite 4 Other							
Grouted Intervals: From 0 ft. to 10 ft., From ft. to ft. to ft. to ft.							
What is the nearest source of possible contamination: 1 Septic tank 4 Cess pool 7 Sewage lagoon 10 Fuel storage 14 Abandoned water well 2 Sewer lines 5 Seepage pit 8 Feed yard 11 Fertilizer storage 15 Oil well/Gas well 3 Lateral lines 6 Pit privy 9 Livestock pens 12 Insecticide storage 16 Other (specify below) 13 Watertight sewer lines							
Direction from well How many feet ? Water Well Disinfected? Yes No							
Was a chemical/bacteriological sample submitted to Department? Yes No If yes, date sample was submitted month day year Pump Installed? Yes No							
If Yes: Pump Manufacturer's name Model No. HP Volts							
Depth of Pump Intake ft. Pumps Capacity rated at gal./min.							
Type of pump: 1 Submersible 2 Turbine 3 Jet 4 Centrifugal 5 Reciprocating 6 Other							
6 CONTRACTOR'S OR LANDOWNER'S CERTIFICATION: This water well was (1) constructed, (2) reconstructed, or (3) plugged under my jurisdiction and was completed on month day year							
and this record is true to the best of my knowledge and belief. Kansas Water Well Contractor's License No.							
This Water Well Record was completed on March month 25 day 1983 year under the business name of by (signature) Patrick M Cobb							
7 LOCATE WELL'S LOCATION WITH AN "X" IN SECTION BOX:		FROM	TO	LITHOLOGIC LOG	FROM	TO	LITHOLOGIC LOG
 ELEVATION: 1795.3				See log from Site #45(1)	04		
					01		
					04		
					17		
					04		
					17		
					03		
					04		
					07		
					01		
			17				
			03				
Depth(s) Groundwater Encountered 1. ft. 2. ft. 3. ft. 4. ft.		(Use a second sheet if needed)					
INSTRUCTIONS: Use typewriter or ball point pen, please press firmly and PRINT clearly. Please fill in blanks, underline or circle the correct answers. Send top three copies to Kansas Department of Health and Environment, Division of Environment, Water Well Contractors, Topeka, KS 66620. Send one to WATER WELL OWNER and retain one for your records.							

OFFICE USE ONLY

T

29

R

11

EW

SEC.

NE 1/4 NE 1/4 SE 1/4

mtp


SITE NUMBER : 45
SITE LOCATION: ~~NE~~ NE SE
SE

LEGAL LOCATION: 1-29-11W
COUNTY : PRATT

[illegible]

SITE NUMBER : 45 SE
SITE LOCATION : NE NE SE
LEGAL LOCATION: 1-29-11W
COUNTY : PRATT

LANDOWNER: EDWIN KRUG
ADDRESS :
PHONE NO.:

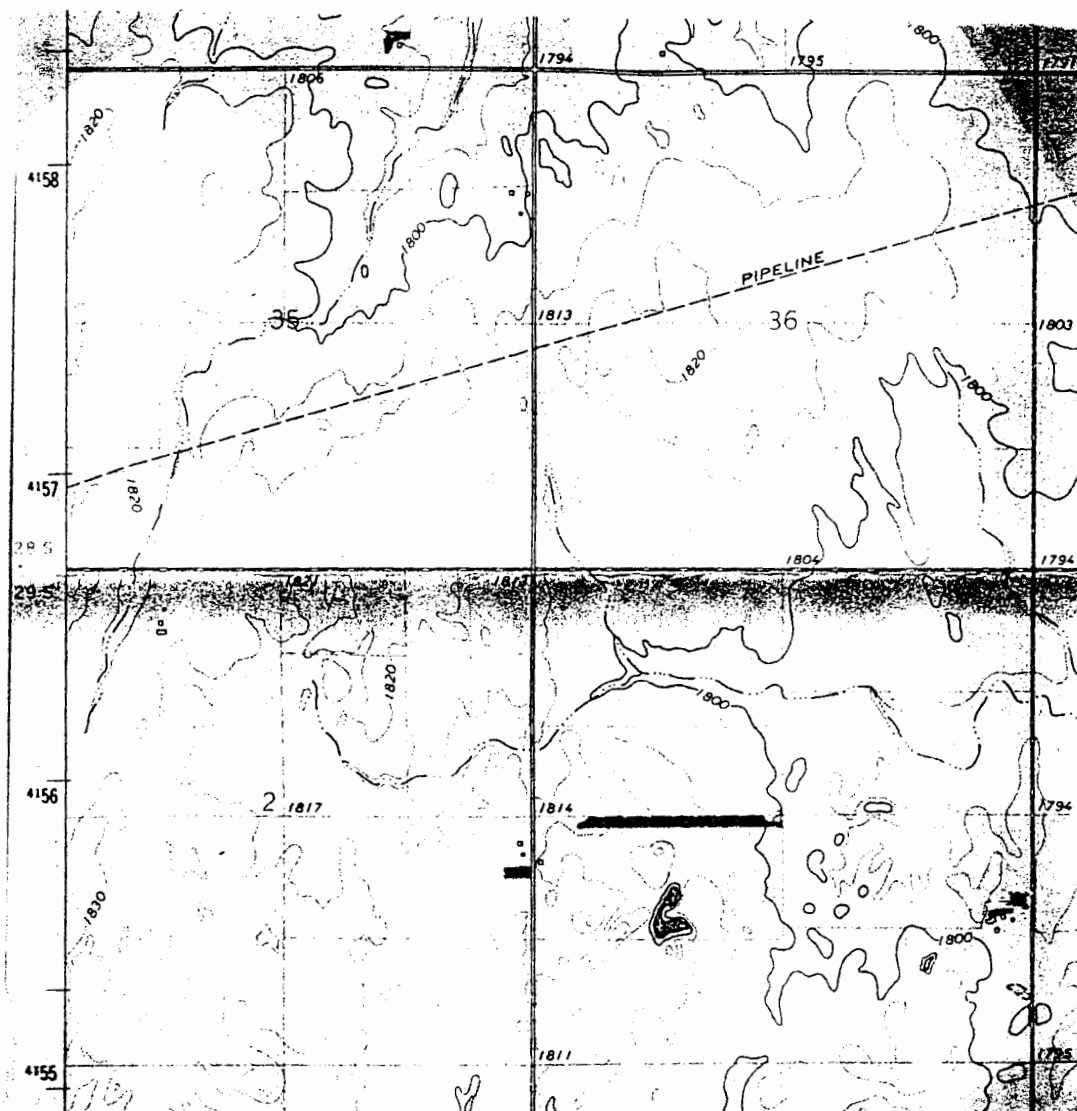

WELL LOCATION X