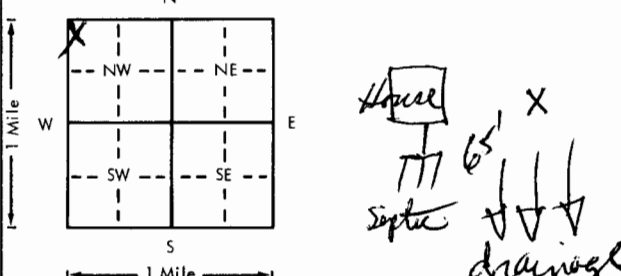


USE TYPEWRITER OR BALL
POINT PEN-PRESS FIRMLY,
PRINT CLEARLY.

WATER WELL RECORD
KSA 82a-1201-1215

Kansas Department of Health and
Environment-Division of Environment
(Water well Contractors)
Topeka, Kansas 66620

1. Location of well:		County <u>Pratt</u>	Fraction <u>NE 1/4 NW 1/4 NW 1/4</u>	Section number <u>10</u>	Township number <u>T 29 S</u>	Range number <u>R 11 W</u>
2. Distance and direction from nearest town or city: <u>5 N + 2 E of</u>		3. Owner of well: <u>Stanton Hirt</u>				
Street address of well location if in city: <u>Isabel, Ka</u>		City, state, zip code: <u>Sawyer, Ka</u>				
4. Locate with "X" in section below: 		6. Bore hole dia. <u>10</u> in. Completion date <u>30 Nov 77</u> Well depth <u>130</u> ft.				
5. Type and color of material		From	To	7. <input checked="" type="checkbox"/> Cable tool <input checked="" type="checkbox"/> Rotary <input type="checkbox"/> Driven <input type="checkbox"/> Dug <input type="checkbox"/> Hollow rod <input type="checkbox"/> Jetted <input type="checkbox"/> Bored <input type="checkbox"/> Reverse rotary		
Silt, sandy		0	2	8. Use: <input checked="" type="checkbox"/> Domestic <input type="checkbox"/> Public supply <input type="checkbox"/> Industry <input type="checkbox"/> Irrigation <input type="checkbox"/> Air conditioning <input type="checkbox"/> Stock <input type="checkbox"/> Lawn <input type="checkbox"/> Oil field water <input type="checkbox"/> Other		
Sand, fine		2	6	9. Casing: Material <input type="checkbox"/> Height: <u>65</u> ft. or below Threaded <input type="checkbox"/> Welded <input type="checkbox"/> Surface <u>12</u> in. RMP <input type="checkbox"/> PVC <input checked="" type="checkbox"/> Weight <input type="checkbox"/> lbs./ft. Dia. <u>5</u> in. to <u>100</u> ft. depth Wall Thickness: inches or Dia. <input type="checkbox"/> in. to <input type="checkbox"/> ft. depth gage No. <u>258</u>		
Clay, white and caliche		6	42	10. Screen: Manufacturer's name <u>Peper</u> Type <u>Sand slot</u> Dia. <u>5</u> Slot/gauze <u>1/8</u> Length <u>30</u> Set between <u>100</u> ft. and <u>130</u> ft. ft. and <input type="checkbox"/> ft. Gravel pack? <input checked="" type="checkbox"/> Size range of material <u>1/4 X 1/4</u>		
Sand, fine to coarse with clay stringers		42	73	11. Static water level: <u>58</u> ft. below land surface Date <u>30 Nov 77</u> mo./day/yr.		
Sand, cemented, hard		73	77	12. Pumping level below land surfaces: <input type="checkbox"/> ft. after <input type="checkbox"/> hrs. pumping <input type="checkbox"/> g.p.m. <input type="checkbox"/> ft. after <input type="checkbox"/> hrs. pumping <input type="checkbox"/> g.p.m. Estimated maximum yield <u>50</u> g.p.m.		
Sand, fine to coarse fine to med. gravel		77	98	13. Water sample submitted: <input type="checkbox"/> Yes <input checked="" type="checkbox"/> No Date <input type="checkbox"/> mo./day/yr.		
Sand, med. to coarse and fine to coarse gravel		98	130	14. Well head completion: <input checked="" type="checkbox"/> Pitless adapter <u>12</u> Inches above grade		
Clay, red		130	135	15. Well grouted? <input type="checkbox"/> With: <input checked="" type="checkbox"/> Neat cement <input type="checkbox"/> Bentonite <input type="checkbox"/> Concrete Depth: From <u>4</u> ft. to <u>14</u> ft.		
Sand, fine to coarse and gravel		135	146	16. Nearest source of possible contamination: ft. <u>65</u> Direction <u>SW</u> Type <u>Septic</u> Well disinfected upon completion? <input checked="" type="checkbox"/> Yes <input type="checkbox"/> No		
Sand, very fine to coarse		146	175	17. Pump: Manufacturer's name <u>SPA RITE</u> Not installed Model number <u>SEA 20</u> HP <u>3/4</u> Volts <u>230</u> Length of drop pipe <u>100</u> ft. capacity <u>15</u> g.p.m. Type: <input checked="" type="checkbox"/> Submersible <input type="checkbox"/> Turbine <input type="checkbox"/> Jet <input type="checkbox"/> Reciprocating <input type="checkbox"/> Centrifugal <input type="checkbox"/> Other		
18. Elevation:		19. Remarks: <u>4'x4'x4" slab below pit adapter</u>		20. Water well contractor's certification: This well was drilled under my jurisdiction and this report is true to the best of my knowledge and belief. <u>Central Well & Pump Svc.</u> 325 Business name License No. Address <u>121 S. Taylor Pratt, Ka.</u> Signed <u>Stanton Hirt</u> Date <u>22 Nov 77</u> Authorized representative		

Forward the white, blue and pink copies to the Department of Health and Environment

Form WWC-5