


1 LOCATION OF WATER WELL:		Fraction	SW	NE	SW	Section	14	Township	29	Range	11
County:	Pratt		1/4	1/4	1/4	Number		T	S	R	1/4

Distance and direction from nearest town or city street address of well if located within city?

Isabel 2½E 3N

2	WATER WELL OWNER:	Emma Hiskett	Sterling Drlg.	
	RR#, St. Address, Box # :	Pratt, Ks. 67124	Box 129	Board of Agriculture, Division of Water Resources
	City, State, ZIP Code :		Sterling, Ks. 67579	Application Number: T89-422

3	LOCATE WELL'S LOCATION WITH AN "X" IN SECTION BOX:	4	DEPTH OF COMPLETED WELL. 95	ft. ELEVATION: Unknown
			20	

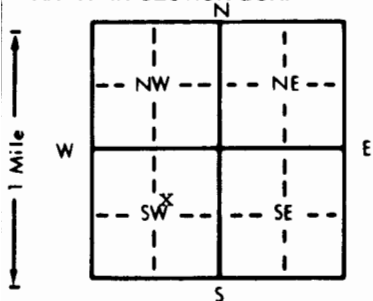

4 DEPTH OF COMPLETED WELL: 95 ft. ELEVATION: Unknown
 Depth(s) Groundwater Encountered 1. 20 ft. 2. ft. 3. ft.
 WELL'S STATIC WATER LEVEL 20 ft. below land surface measured on mo/day/yr 9/26/89
 Pump test data: Well water was ft. after hours pumping gpm
 Est. Yield 100 gpm: Well water was ft. after hours pumping gpm
 Bore Hole Diameter 8 in. to 95 ft., and in. to ft.
 WELL WATER TO BE USED AS:
 1 Domestic 3 Feedlot 6 Oil field water supply 8 Air conditioning 11 Injection well
 2 Irrigation 4 Industrial 7 Lawn and garden only 9 Dewatering 12 Other (Specify below)
 10 Monitoring well
 Was a chemical/bacteriological sample submitted to Department? Yes.....No.....X.....; If yes, mo/day/yr sample was submitted
 Water Well Disinfected? Yes No X

5	TYPE OF BLANK CASING USED:		5 Wrought iron	8 Concrete tile	CASING JOINTS: Glued . . X . . Clamped Welded Threaded
	1 Steel	3 RMP (SR)	6 Asbestos-Cement	9 Other (specify below)	
	2 PVC	4 ABS	7 Fiberglass		

Blank casing diameter . . . 5 . . . in. to . 7.5 . . . ft., Dia . . . in. to . . . ft., Dia . . . in. to . . . ft.
Casing height above land surface . . 12 . . . in., weight . . 2.8 . . . lbs./ft. Wall thickness or gauge No. . . Sch. 40

TYPE OF SCREEN OR PERFORATION MATERIAL:			7 PVC	10 Asbestos-cement
1 Steel	3 Stainless steel	5 Fiberglass	8 RMP (SR)	11 Other (specify)
2 Brass	4 Galvanized steel	6 Concrete tile	9 ABS	12 None used (open hole)

SCREEN OR PERFORATION OPENINGS ARE:

1 Continuous slot	3 Mill slot	5 Gauzed wrapped	8 <u>Saw cut</u>	11 None (open hole)
2 Louvered shutter	4 Key punched	6 Wire wrapped	9 Drilled holes	
		7 Torch cut	10 Other (specify)	

SCREEN-PERFORATED INTERVALS:	From . . . 75 ft. to . . . 95 ft.,	From ft. to ft.
	From ft. to ft.,	From ft. to ft.
GRAVEL PACK INTERVALS:	From . . . 20 ft. to 95 ft.,	From ft. to ft.
	From ft. to ft.,	From ft. to ft.

6	GROUT MATERIAL:		1 Neat cement	2 Cement grout	3 Bentonite	4 Other
	Grout Intervals:	From	0 ft. to 20 ft.	From	ft. to	ft. to

What is the nearest source of possible contamination:

1 Septic tank	4 Lateral lines	7 Pit privy	10 Livestock pens	14 Abandoned water well
2 Sewer lines	5 Cess pool	8 Sewage lagoon	11 Fuel storage	15 <u>Oil well</u> /Gas well
3 Watertight sewer lines	6 Seepage pit	9 Feedyard	12 Fertilizer storage	16 Other (specify below)
Direction from well?	South		13 Insecticide storage
			How many feet?	275

[illegible]

7. CONTRACTOR'S OR LANDOWNER'S CERTIFICATION: This water well was (1) constructed, (2) reconstructed, or (3) plugged under my jurisdiction and was completed on (mo/day/year) 9/26/89 and this record is true to the best of my knowledge and belief. Kansas Water Well Contractor's License No. 186 This Water Well Record was completed on (mo/day/yr) 10/16/89 under the business name of [Signature] bv (signature)

INSTRUCTIONS: Use typewriter or ball point pen. PLEASE PRESS FIRMLY and PRINT clearly. Please fill in blanks, underline or circle the correct answers. Send top three copies to Kansas Department of Health and Environment, Bureau of Water Protection, Topeka, Kansas 66620-7320. Telephone: 913-296-5514. Send one to WATER WELL OWNER and retain one for your records.