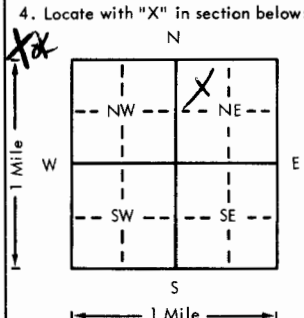


USE TYPEWRITER OR BALL
POINT PEN-PRESS FIRMLY,
PRINT CLEARLY.

WATER WELL RECORD
KSA 82a-1201-1215

Kansas Department of Health and
Environment-Division of Environment
(Water well Contractors)
Topeka, Kansas 66620

1. Location of well: County <u>PRATT</u> Fraction <u>1/4 NE 1/4</u> Section number <u>16</u> Township number <u>29S</u> Range number <u>11W</u>	
2. Distance and direction from nearest town or city: <u>1 mile EAST 1 SOUTH 1980 EAST</u> Street address of well location if in city: <u>CARLE 7 SOUTH</u>	
3. Owner of well: <u>D. R. Lauck Oil Co.</u> R.R. or street: <u>301 S. Broadway</u> City, state, zip code: <u>Wichita KS. 67202</u>	
4. Locate with "X" in section below: Sketch map: 	
6. Bore hole dia. <u>9</u> in. Completion date <u>1-12-79</u> Well depth <u>120</u> ft.	
7. <input type="checkbox"/> Cable tool <input checked="" type="checkbox"/> Rotary <input type="checkbox"/> Driven <input type="checkbox"/> Dug <input type="checkbox"/> Hollow rod <input type="checkbox"/> Jetted <input type="checkbox"/> Bored <input type="checkbox"/> Reverse rotary	
8. Use: <input type="checkbox"/> Domestic <input type="checkbox"/> Public supply <input type="checkbox"/> Industry <input type="checkbox"/> Irrigation <input type="checkbox"/> Air conditioning <input type="checkbox"/> Stock <input type="checkbox"/> Lawn <input checked="" type="checkbox"/> Oil field water <input type="checkbox"/> Other	
9. Casing: Material <input type="checkbox"/> Threaded <input type="checkbox"/> Welded <input checked="" type="checkbox"/> Surface <u>12</u> in. RMP <input type="checkbox"/> PVC <input checked="" type="checkbox"/> Weight <u>278-3</u> lbs./ft. Dia. <u>5</u> in. to <u>120</u> ft. depth Wall Thickness: inches or Dia. <u>5</u> in. to <u>120</u> ft. depth Gage No. <u>200</u>	
10. Screen: Manufacturer's name <u>Peerless</u> Type <u>Saw</u> Dia. <u>5</u> Slot/gauze <u>18</u> Length <u>20</u> Set between <u>120</u> ft. and <u>100</u> ft. Gravel pack? <input checked="" type="checkbox"/> Size range of material <u>14-18</u>	
11. Static water level: <u>60</u> ft. below land surface Date <u>1-12-79</u> mo./day/yr.	
12. Pumping level below land surfaces: <u>60</u> ft. after <u>1</u> hrs. pumping <u>60</u> g.p.m. <u>60</u> ft. after <u>1</u> hrs. pumping <u>60</u> g.p.m. Estimated maximum yield <u>60</u> g.p.m.	
13. Water sample submitted: <u>Yes</u> <input checked="" type="checkbox"/> No <input type="checkbox"/> Date <u>1-12-79</u> mo./day/yr.	
14. Well head completion: <u>Pitless adapter</u> <u>12</u> inches above grade	
15. Well grouted? <input checked="" type="checkbox"/> With: <u>Neat cement</u> <input checked="" type="checkbox"/> Bentonite <input type="checkbox"/> Concrete Depth: From <u>12</u> ft. to <u>10</u> ft.	
16. Nearest source of possible contamination: <u>None</u> ft. <u>None</u> Direction <u>None</u> Type <u>None</u> Well disinfected upon completion? <u>Yes</u> <input checked="" type="checkbox"/> No <input type="checkbox"/>	
17. Pump: <input checked="" type="checkbox"/> Not installed Manufacturer's name <u>None</u> Model number <u>None</u> HP <u>None</u> Volts <u>None</u> Length of drop pipe <u>None</u> ft. capacity <u>None</u> g.p.m. Type: <input type="checkbox"/> Submersible <input type="checkbox"/> Turbine <input type="checkbox"/> Jet <input type="checkbox"/> Reciprocating <input type="checkbox"/> Centrifugal <input type="checkbox"/> Other	
(Use a second sheet if needed)	
18. Elevation: Topography: <input type="checkbox"/> Hill <input checked="" type="checkbox"/> Slope <input type="checkbox"/> Upland <input type="checkbox"/> Valley	19. Remarks: 20. Water well contractor's certification: This well was drilled under my jurisdiction and this report is true to the best of my knowledge and belief. <u>MURS Water Well</u> <u>143</u> Business name License No. <u>Great Bend KS</u> Address: <u>Great Bend KS</u> Signed: <u>Floyd Randall</u> Date: <u>1-12-79</u> Authorized representative

Forward the white, blue and pink copies to the Department of Health and Environment

Form WWC-5