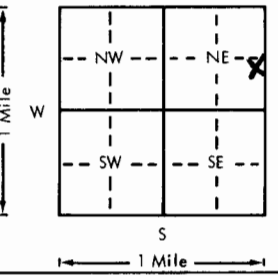
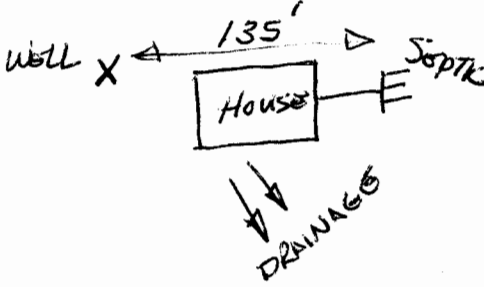


USE TYPEWRITER OR BALL
POINT PEN-PRESS FIRMLY,
PRINT CLEARLY.

WATER WELL RECORD
KSA 82a-1201-1215

Kansas Department of Health and
Environment-Division of Environment
(Water well Contractors)
Topeka, Kansas 66620

1. Location of well:		County Pratt	Fraction NE 1/4 SE 1/4 NE 1/4	Section number 21	Township number T 29 S R 12 W E/W	Range number
2. Distance and direction from nearest town or city: 3 E & 3/4 N			3. Owner of well: Leonard Kessler			
Street address of well location if in city: OF SAWYER, KS			City, state, zip code: Sawyer, Kansas			
4. Locate with "X" in section below:		Sketch map:		6. Bore hole dia. 10 in. Completion date 13 July 79		
				Well depth 120 ft.		
5. Type and color of material		From	To	7. <input checked="" type="checkbox"/> Cable tool <input checked="" type="checkbox"/> Rotary <input type="checkbox"/> Driven <input type="checkbox"/> Dug <input type="checkbox"/> Hollow rod <input type="checkbox"/> Jetted <input type="checkbox"/> Bored <input type="checkbox"/> Reverse rotary		
Soil		0	3	8. Use: <input checked="" type="checkbox"/> Domestic <input type="checkbox"/> Public supply <input type="checkbox"/> Industry <input type="checkbox"/> Irrigation <input type="checkbox"/> Air conditioning <input type="checkbox"/> Stock <input type="checkbox"/> Lawn <input type="checkbox"/> Oil field water <input type="checkbox"/> Other		
Clay, Brown		3	45	9. Casing: Material <input type="checkbox"/> Height: <input checked="" type="checkbox"/> Above or below Threaded <input type="checkbox"/> Welded <input type="checkbox"/> Surface 12 in. RMP <input checked="" type="checkbox"/> PVC <input type="checkbox"/> Weight <input type="checkbox"/> lbs./ft. Dia. 5 in. to 80 ft. depth Wall Thickness: inches or Dia. <input type="checkbox"/> in. to <input type="checkbox"/> ft. depth gage No. 200		
Sand, fine		45	69	10. Screen: Manufacturer's name MODERN - F&W Supply Type SLOT Dia. 5 in. Slot/gauze 1/16 Length 40 ft. Set between 80 ft. and 120 ft. ft. and <input type="checkbox"/> ft.		
Clay, brown		69	78	Gravel pack? Yes Size range of material 1/8 x 3/8		
Sand, fine to medium and fine gravel		78	119	11. Static water level: <input type="checkbox"/> mo./day/yr. 60 ft. below land surface Date 13 July 79		
Clay, brown		119	120	12. Pumping level below land surfaces: ft. after <input type="checkbox"/> hrs. pumping <input type="checkbox"/> g.p.m. ft. after <input type="checkbox"/> hrs. pumping <input type="checkbox"/> g.p.m. Estimated maximum yield 70 g.p.m.		
				13. Water sample submitted: <input type="checkbox"/> Yes <input checked="" type="checkbox"/> No Date <input type="checkbox"/> mo./day/yr.		
				14. Well head completion: <input checked="" type="checkbox"/> Pitless adapter 12 Inches above grade		
				15. Well grouted? Yes With: <input checked="" type="checkbox"/> Neat cement <input type="checkbox"/> Bentonite <input type="checkbox"/> Concrete Depth: From 4 ft. to 14 ft.		
				16. Nearest source of possible contamination: ft. 135 Direction EAST Type SEPTIC Well disinfected upon completion? <input checked="" type="checkbox"/> Yes <input type="checkbox"/> No		
				17. Pump: <input type="checkbox"/> Not installed Manufacturer's name STA-RITE Model number SER 20 HP 1 Volts 230 Length of drop pipe 85 ft. capacity 27 g.p.m. Type: <input checked="" type="checkbox"/> Submersible <input type="checkbox"/> Turbine <input type="checkbox"/> Jet <input type="checkbox"/> Reciprocating <input type="checkbox"/> Centrifugal <input type="checkbox"/> Other		
18. Elevation:		19. Remarks:		20. Water well contractor's certification: This well was drilled under my jurisdiction and this report is true to the best of my knowledge and belief. Central Well & Pump, Inc. 325 Business name Box 1032 PRATT, KS License No. Address Edmond Signed Edmond Date AUG 79 Authorized representative		
Topography: <input type="checkbox"/> Hill <input type="checkbox"/> Slope <input checked="" type="checkbox"/> Upland <input type="checkbox"/> Valley						

Forward the white, blue and pink copies to the Department of Health and Environment

Form WWC-5