

1 LOCATION OF WATER WELL:	Fraction	Section Number	Township Number	Range Number
County: Pratt	SW NW ¼ SW NW ¼ SW ¼	21	T 29 S	R 12W E/W

Distance and direction from nearest town or city street address of well if located within city?


2 E of Sawver, Kansas

Danner

2] WATER WELL OWNER:	John Douner	Sterling Drilling Co.	Douner 1-21
RR#, St. Address, Box # :	Pratt, Ks.	Box 129	Board of Agriculture, Division of Water Resources
City, State, ZIP Code :	67124	Sterling, Ks. 67579	Application Number: 900500

3 LOCATE WELL'S LOCATION WITH AN "X" IN SECTION BOX:

4 DEPTH OF COMPLETED WELL: 170 ft. ELEVATION: Unknown

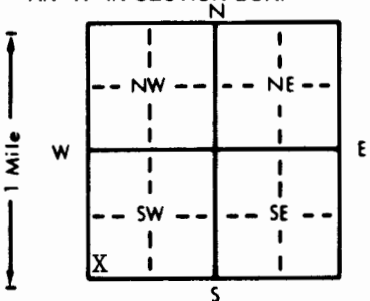

Depth(s) Groundwater Encountered 1. 90 ft. 2. ft. 3. ft. ft.
WELL'S STATIC WATER LEVEL 90 ft. below land surface measured on mo/day/yr 11/8/90
Pump test data: Well water was ft. after hours pumping gpm
Est. Yield 60 gpm: Well water was ft. after hours pumping gpm
Bore Hole Diameter 8 in. to 170 ft., and in. to ft.
WELL WATER TO BE USED AS: 5 Public water supply 8 Air conditioning 11 Injection well
1 Domestic 3 Feedlot 6 Oil field water supply 9 Dewatering 12 Other (Specify below)
2 Irrigation 4 Industrial 7 Lawn and garden only 10 Monitoring well
Was a chemical/bacteriological sample submitted to Department? Yes No; If yes, mo/day/yr sample was sub-
mitted Water Well Disinfected? Yes No

5	TYPE OF BLANK CASING USED:		5 Wrought iron	8 Concrete tile	CASING JOINTS: <u>Glued</u> Clamped <u>Welded</u> <u>Threaded</u>
	1 Steel	3 RMP (SR)	6 Asbestos-Cement	9 Other (specify below)	
	2 PVC	4 ABS	7 Fiberglass		

Blank casing diameter 5 . . . in. to 150 . . . ft., Dia in. to . . . ft., Dia in. to . . . ft.
Casing height above land surface 12 in., weight 2.8 . . . lbs./ft. Wall thickness or gauge No. Sch. 40

TYPE OF SCREEN OR PERFORATION MATERIAL:			7 <u>PVC</u>	10 Asbestos-cement
1 Steel	3 Stainless steel	5 Fiberglass	8 RMP (SR)	11 Other (specify)
2 Brass	4 Galvanized steel	6 Concrete tile	9 ABS	12 None used (open hole)

SCREEN OR PERFORATION OPENINGS ARE:

1 Continuous slot	3 Mill slot	5 Gauzed wrapped	8 <u>Saw cut</u>	11 None (open hole)
2 Louvered shutter	4 Key punched	6 Wire wrapped	9 Drilled holes	
		7 Torch cut	10 Other (specify)	

SCREEN-PERFORATED INTERVALS: From 150 ft. to 170 ft., From ft. to ft.
From ~~20~~ ft. to ~~170~~ ft., From ft. to ft.

GRAVEL PACK INTERVALS: From 20 ft. to 170 ft., From ft. to ft.
From ft. to ft., From ft. to ft.

6	GROUT MATERIAL:													
	1 Neat cement		2 Cement grout		3 Bentonite		4 Other							
	Grout Intervals:	From	0	ft. to	20	ft.	From	ft.	to	ft.	From	ft.	to	ft.

What is the nearest source of possible contamination:

1 Septic tank	4 Lateral lines	7 Pit privy	10 Livestock pens	14 Abandoned water well
2 Sewer lines	5 Cess pool	8 Sewage lagoon	11 Fuel storage	15 <u>Oil well/Gas well</u>
3 Watertight sewer lines	6 Seepage pit	9 Feedyard	12 Fertilizer storage	16 <u>Other (specify below)</u>
Direction from well?	South		13 Insecticide storage	
			How many feet?	60

7 CONTRACTOR'S OR LANDOWNER'S CERTIFICATION: This water well was (1) constructed, (2) reconstructed, or (3) plugged under my jurisdiction and was completed on (mo/day/year) 11/8/90 and this record is true to the best of my knowledge and belief. Kansas Water Well Contractor's License No. 186 This Water Well Record was completed on (mo/day/yr) 2/14/91 under the business name of Kelly's Water Well Service bv (signature) 