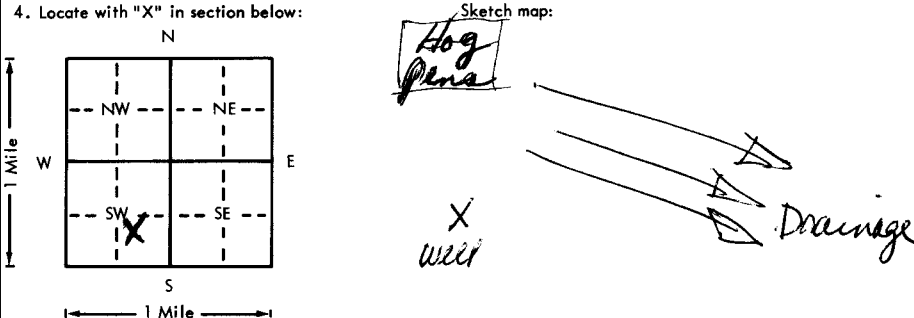


USE TYPEWRITER OR BALL  
POINT PEN-PRESS FIRMLY,  
PRINT CLEARLY.

WATER WELL RECORD  
KSA 82a-1201-1215

Kansas Department of Health and  
Environment-Division of Environment  
(Water well Contractors)  
Topeka, Kansas 66620

1. Location of well:	County <b>PRATT</b>	Fraction <b>NW 1/4 SE 1/4 SW 1/4</b>	Section number <b>23</b>	Township number <b>T 29 S</b>	Range number <b>R 12 W E/W</b>
2. Distance and direction from nearest town or city: <b>4 1/4 E of Sawyer, Ks</b>			3. Owner of well: <b>DOYLE BOYD</b>		
Street address of well location if in city:			R.R. or street:		
City, state, zip code: <b>Sawyer, Ks</b>			City, state, zip code: <b>Sawyer, Ks</b>		
4. Locate with "X" in section below: 			6. Bore hole dia. <b>10</b> in. Completion date <b>14 July 78</b> Well depth <b>120</b> ft.		
			7. <input checked="" type="checkbox"/> Cable tool <input checked="" type="checkbox"/> Rotary <input type="checkbox"/> Driven <input type="checkbox"/> Dug <input type="checkbox"/> Hollow rod <input type="checkbox"/> Jetted <input type="checkbox"/> Bored <input type="checkbox"/> Reverse rotary		
			8. Use: <input type="checkbox"/> Domestic <input type="checkbox"/> Public supply <input type="checkbox"/> Industry <input type="checkbox"/> Irrigation <input type="checkbox"/> Air conditioning <input checked="" type="checkbox"/> Stock <input type="checkbox"/> Lawn <input type="checkbox"/> Oil field water <input type="checkbox"/> Other		
			9. Casing: Material <input type="checkbox"/> Height: Above or below Threaded <input type="checkbox"/> Welded <input type="checkbox"/> Surface <b>12</b> in. RMP <input type="checkbox"/> PVC <input checked="" type="checkbox"/> Weight <input type="checkbox"/> lbs./ft. Dia <b>5</b> in. to <b>100</b> ft. depth Wall Thickness: inches or Dia. <input type="checkbox"/> in. to <input type="checkbox"/> ft. depth gage No. <b>258</b>		
5. Type and color of material			From	To	10. Screen: Manufacturer's name <b>Pitless</b>
<b>Silt</b>			<b>0</b>	<b>2</b>	Type <b>Saw slot</b> Dia. <b>5</b> in.
<b>Clay, Brown</b>			<b>2</b>	<b>15</b>	Slot/gauze <b>1/8</b> Length <b>20</b> ft.
<b>Sand, med &amp; med gravel</b>			<b>15</b>	<b>17</b>	Set between <b>100</b> ft. and <b>120</b> ft.
<b>Clay, Tan</b>			<b>17</b>	<b>35</b>	Gravel pack? <input checked="" type="checkbox"/> Size range of material <b>1/4 X 1/4</b>
<b>Sand, fine to coarse w/ clay streaks</b>			<b>35</b>	<b>59</b>	11. Static water level: <b>52</b> ft. below land surface Date <b>14 July 78</b>
<b>Sand, fine to coarse</b>			<b>59</b>	<b>71</b>	12. Pumping level below land surfaces: ft. after hrs. pumping g.p.m. ft. after hrs. pumping g.p.m. Estimated maximum yield <b>50</b> g.p.m.
<b>Sand, fine to coarse &amp; some gravel</b>			<b>71</b>	<b>100</b>	13. Water sample submitted: <input checked="" type="checkbox"/> Yes <input type="checkbox"/> No Date
<b>Sand, fine to coarse &amp; coarse gravel</b>			<b>100</b>	<b>120</b>	14. Well head completion: <input checked="" type="checkbox"/> Pitless adapter <b>12</b> inches above grade
					15. Well grouted? <input checked="" type="checkbox"/> With: <input checked="" type="checkbox"/> Neat cement <input type="checkbox"/> Bentonite <input type="checkbox"/> Concrete Depth: From <b>4</b> ft. to <b>14</b> ft.
					16. Nearest source of possible contamination: ft. <b>250</b> Direction <b>North</b> Type <b>Hog Pens</b> Well disinfected upon completion? <input type="checkbox"/> Yes <input type="checkbox"/> No
					17. Pump: <input type="checkbox"/> Not installed Manufacturer's name <b>Star Rite</b> Model number <b>20</b> HP <b>1</b> Volts Length of drop pipe <b>100</b> ft. capacity <b>30</b> g.p.m. Type: <input checked="" type="checkbox"/> Submersible <input type="checkbox"/> Turbine <input type="checkbox"/> Jet <input type="checkbox"/> Reciprocating <input type="checkbox"/> Centrifugal <input type="checkbox"/> Other
					20. Water well contractor's certification: This well was drilled under my jurisdiction and this report is true to the best of my knowledge and belief. <b>Central Well &amp; Pump</b> <b>325</b> Business name License No. Address <b>1215 Taylor Pratt Ks</b> Signed <b>John Bonomick</b> Date <b>20 July 78</b> Authorized representative
18. Elevation:			19. Remarks: <b>4' x 4' x 4" Slab poured below pitless adapter</b>		
Topography: <input type="checkbox"/> Hill <input type="checkbox"/> Slope <input checked="" type="checkbox"/> Upland <input type="checkbox"/> Valley					

Forward the white, blue and pink copies to the Department of Health and Environment

Form WWC-5