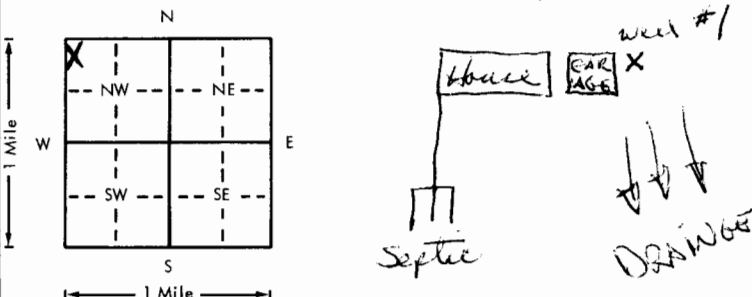


USE TYPEWRITER OR BALL  
POINT PEN-PRESS FIRMLY,  
PRINT CLEARLY.

WATER WELL RECORD  
KSA 82a-1201-1215

Kansas Department of Health and  
Environment-Division of Environment  
(Water well Contractors)  
Topeka, Kansas 66620

1. Location of well:	County <b>PRATT</b>	Fraction <b>NW 1/4 NW 1/4 NW 1/4</b>	Section number <b>29</b>	Township number <b>T 29 S</b>	Range number <b>R 12 W E/W</b>
2. Distance and direction from nearest town or city: Street address of well location if in city:	<b>1 E of Sawyer, KS</b>		3. Owner of well: <b>VERNON HIRT</b> R.R. or street: City, state, zip code: <b>Sawyer, KS</b>		
4. Locate with "X" in section below: Sketch map:			6. Bore hole dia. <b>10</b> in. Completion date <b>11 Sept 79</b> Well depth <b>180</b> ft.		
5. Type and color of material	From	To	7. <input checked="" type="checkbox"/> Cable tool <input checked="" type="checkbox"/> Rotary <input type="checkbox"/> Driven <input type="checkbox"/> Dug <input type="checkbox"/> Hollow rod <input type="checkbox"/> Jetted <input type="checkbox"/> Bored <input type="checkbox"/> Reverse rotary		
<b>Soil</b>	<b>0</b>	<b>2</b>	8. Use: <input checked="" type="checkbox"/> Domestic <input type="checkbox"/> Public supply <input type="checkbox"/> Industry <input type="checkbox"/> Irrigation <input type="checkbox"/> Air conditioning <input type="checkbox"/> Stock <input type="checkbox"/> Lawn <input type="checkbox"/> Oil field water <input type="checkbox"/> Other		
<b>Clay, Brown</b>	<b>2</b>	<b>30</b>	9. Casing: Material <input type="checkbox"/> Height, Above or below Threaded <input type="checkbox"/> Welded <input type="checkbox"/> Surface <b>12</b> in. RMP <input type="checkbox"/> PVC <input checked="" type="checkbox"/> Weight <input type="checkbox"/> lbs./ft. Dia. <b>5</b> in. to <b>110</b> ft. depth Wall Thickness: inches or Dia. <input type="checkbox"/> in. to <input type="checkbox"/> ft. depth gage No. <b>258</b>		
<b>Clay, Brown w/ Sand streaks</b>	<b>30</b>	<b>60</b>	10. Screen: Manufacturer's name <b>Pattless</b> Type <b>Saw slot</b> Dia. <b>5"</b> Slot/gauze <b>48</b> Length <b>40'</b> Set between <b>110'</b> ft. and <b>130'</b> ft. <b>160'</b> ft. and <b>180'</b> ft. Gravel pack? <input checked="" type="checkbox"/> Size range of material <b>1/4 X 1/4</b>		
<b>Sand, fine to Coarse - Cemented</b>	<b>60</b>	<b>91</b>	11. Static water level: <input type="checkbox"/> mo./day/yr. <b>97</b> ft. below land surface Date <b>11 Sept 78</b>		
<b>Sand, Cemented w/ clay streaks</b>	<b>91</b>	<b>95</b>	12. Pumping level below land surfaces: ____ ft. after ____ hrs. pumping ____ g.p.m. ____ ft. after ____ hrs. pumping ____ g.p.m. Estimated maximum yield <b>100</b> g.p.m.		
<b>Sand, med to Coarse &amp; gravel</b>	<b>95</b>	<b>105</b>	13. Water sample submitted: <input type="checkbox"/> mo./day/yr. Yes <input checked="" type="checkbox"/> No <input type="checkbox"/> Date		
<b>Sand, Coarse &amp; Coarse gravel</b>	<b>105</b>	<b>130</b>	14. Well head completion: <input checked="" type="checkbox"/> Pitless adapter <b>12</b> inches above grade		
<b>Clay, Brown</b>	<b>130</b>	<b>141</b>	15. Well grouted? <input checked="" type="checkbox"/> With: <input checked="" type="checkbox"/> Neat cement <input type="checkbox"/> Bentonite <input type="checkbox"/> Concrete Depth: From <b>4</b> ft. to <b>14</b> ft.		
<b>Sand, fine to Coarse &amp; fine gravel</b>	<b>141</b>	<b>190</b>	16. Nearest source of possible contamination: ft. <b>140</b> Direction <b>SW</b> Type <b>Septic</b> Well disinfected upon completion? <input checked="" type="checkbox"/> Yes <input type="checkbox"/> No		
(Use a second sheet if needed)			17. Pump: Not installed Manufacturer's name <b>STARITE</b> Model number <b>20</b> HP <b>1</b> Volts <b>115</b> Length of drop pipe <b>140</b> ft. capacity <b>35</b> g.p.m. Type: <input checked="" type="checkbox"/> Submersible <input type="checkbox"/> Turbine <input type="checkbox"/> Jet <input type="checkbox"/> Reciprocating <input type="checkbox"/> Centrifugal <input type="checkbox"/> Other		
18. Elevation:	19. Remarks: <b>4' X 4' X 4" slab poured below pitless adapter</b>		20. Water well contractor's certification: This well was drilled under my jurisdiction and this report is true to the best of my knowledge and belief. <b>Central Well &amp; Pump 325</b> Business name License No. Address <b>121 S. Taylor Pratt KS</b> Signed <b>J. Abromick</b> Date <b>1/20/78</b> Authorized representative		

Forward the white, blue and pink copies to the Department of Health and Environment

Form WWC-5