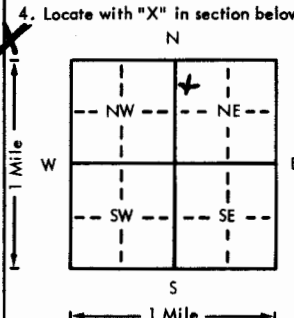


USE TYPEWRITER OR BALL
POINT PEN-PRESS FIRMLY,
PRINT CLEARLY.

WATER WELL RECORD
KSA 82a-1201-1215

Kansas Department of Health and
Environment-Division of Environment
(Water well Contractors)
Topeka, Kansas 66620

1. Location of well:		County Pratt	Fraction 1/4 NW 1/4 NE 1/4	Section number 9	Township number 29	Range number 13 E
2. Distance and direction from nearest town or city: Street address of well location if in city: 3 nw Sawyer				3. Owner of well: John Grover R.R. or street: Box 55A City, state, zip code: Sawyer, KS. 67134		
4. Locate with "X" in section below: 				Sketch map:		
5. Type and color of material				From	To	
6. Bore hole dia. 10 in. Completion date 12-27-78 Well depth 102 ft.				7. Cable tool <input checked="" type="checkbox"/> Rotary <input type="checkbox"/> Driven <input type="checkbox"/> Dug <input type="checkbox"/> Hollow rod <input type="checkbox"/> Jetted <input type="checkbox"/> Bored <input type="checkbox"/> Reverse rotary		
8. Use: <input type="checkbox"/> Domestic <input type="checkbox"/> Public supply <input type="checkbox"/> Industry <input type="checkbox"/> Irrigation <input type="checkbox"/> Air conditioning <input checked="" type="checkbox"/> Stock <input type="checkbox"/> Lawn <input type="checkbox"/> Oil field water <input type="checkbox"/> Other				9. Casing: Material pvc Height: Above or below Threaded <input type="checkbox"/> Welded <input type="checkbox"/> 36 1/2 in. RMP <input type="checkbox"/> PVC <input checked="" type="checkbox"/> Weight 280 lbs./ft. Dia. <input type="checkbox"/> in. to <input type="checkbox"/> ft. depth Wall thickness: inches or Dia. <input type="checkbox"/> in. to <input type="checkbox"/> ft. depth gage No.		
10. Screen: Manufacturer's name Pumpco Type pvc Dia. 18 Slot/gauze 025 Length 100 Set between 90 ft. and 100 ft. ft. and 100 ft. Gravel pack? <input checked="" type="checkbox"/> Size range of material 1/4 in.				11. Static water level: 72 ft. below land surface Date 12-27-78 mo./day/yr.		
12. Pumping level below land surfaces: ft. after <input type="checkbox"/> hrs. pumping <input type="checkbox"/> g.p.m. ft. after <input type="checkbox"/> hrs. pumping <input type="checkbox"/> g.p.m. Estimated maximum yield 100 g.p.m.				13. Water sample submitted: <input type="checkbox"/> Yes <input checked="" type="checkbox"/> No Date		
14. Well head completion: <input checked="" type="checkbox"/> Pitless adapter 15 inches above grade				15. Well grouted? <input checked="" type="checkbox"/> With: <input checked="" type="checkbox"/> Neat cement <input type="checkbox"/> Bentonite <input type="checkbox"/> Concrete Depth: From 3 ft. to 15 ft.		
16. Nearest source of possible contamination: ft. n Direction 100 Type hog house Well disinfected upon completion? <input checked="" type="checkbox"/> Yes <input type="checkbox"/> No				17. Pump: <input checked="" type="checkbox"/> Not installed Manufacturer's name Jacuzzi Model number 5x HP 5 Volts 230 Length of drop pipe 80 ft. capacity 60 g.p.m. Type: <input checked="" type="checkbox"/> Submersible <input type="checkbox"/> Turbine <input type="checkbox"/> Jet <input type="checkbox"/> Reciprocating <input type="checkbox"/> Centrifugal <input type="checkbox"/> Other		
18. Elevation:				19. Remarks: customer to pour slab		
20. Water well contractor's certification: This well was drilled under my jurisdiction and this report is true to the best of my knowledge and belief. LYMAN BROS 140 Business name MEP LOGS KS License No. Address W. A. Lyman Date 12-27-78 Signed W. A. Lyman Authorized representative						

Forward the white, blue and pink copies to the Department of Health and Environment

Form WWC-5