

1

BIG BEND GMD#5-KGS
WATER QUALITY
OBSERVATION WELL
NETWORK

SITE NUMBER : 47
SITE LOCATION: NW NE NE


LEGAL LOCATION: 12-29-13W
COUNTY : PRATT

WELL LOG

[illegible]

SITE NUMBER : 47
SITE LOCATION : NW NW NE
LEGAL LOCATION: 12-29-13W
COUNTY : PRATT

LANDOWNER: DON FINCHAM
ADDRESS :
PHONE NO.: (316)-672-3676

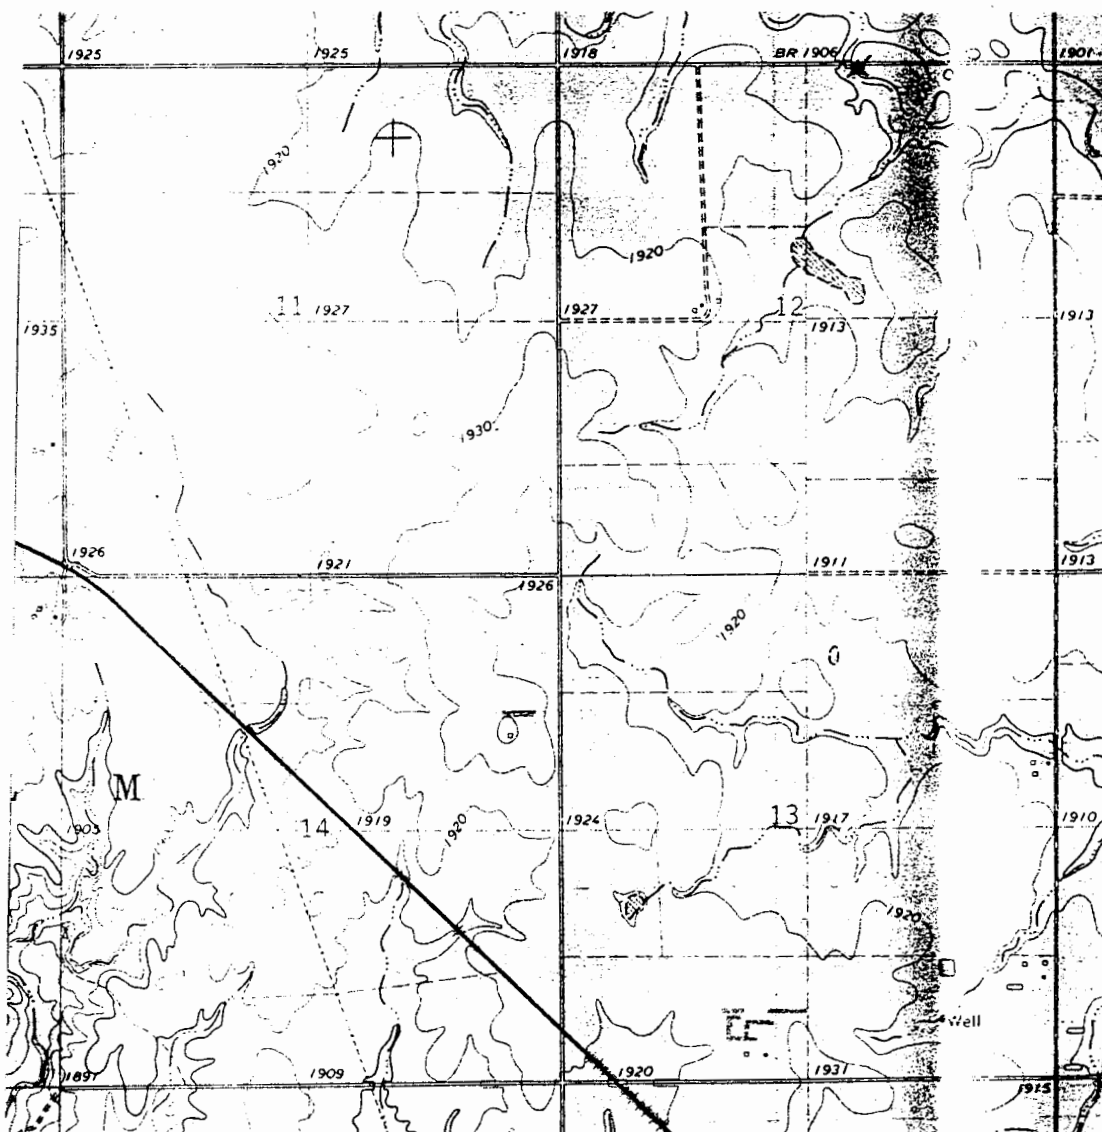

WELL LOCATION X