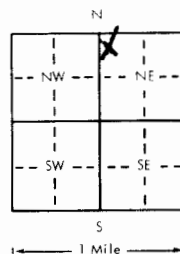


Site #47(3)

WATER WELL RECORD

Form WWC-5

KSA 82a-1212

1 LOCATION OF WATER WELL		Fraction	Section Number		Township Number	Range Number
County: Pratt		NW 1/4 NW 1/4 NE 1/4	12		T 29 S	R 13 EW
Distance and direction from nearest town or city? 3 mi N, 1/2 mi W of Sawyer			Street address of well if located within city?			
2 WATER WELL OWNER: KGS/GWMD#5						
RR#, St. Address, Box # : City, State, ZIP Code :						
Board of Agriculture, Division of Water Resources Application Number:						
3 DEPTH OF COMPLETED WELL... 87 ...ft. Bore Hole Diameter... 9-7/8 ...in. to 87 ...ft., and ...in. to ...ft.						
Well Water to be used as: 1 Domestic 3 Feedlot 5 Public water supply 8 Air conditioning 11 Injection well 2 Irrigation 4 Industrial 6 Oil field water supply 9 Dewatering 12 Other (Specify below) 7 Lawn and garden only 10 Observation well						
Well's static water level... 71.2 ...ft. below land surface measured on January ...month 27 ...day 1983 ...year						
Pump Test Data Est. Yield gpm: Well water was ...ft. after ...hours pumping. gpm Well water was ...ft. after ...hours pumping. gpm						
4 TYPE OF BLANK CASING USED: 1 Steel 3 RMP (SR) 5 Wrought iron 8 Concrete tile Casing Joints: Glued ...Clamped ... 2 PVC 4 ABS 6 Asbestos-Cement 9 Other (specify below) Welded ... 7 Fiberglass Threaded ...						
Blank casing dia... 5 ...in. to 82 ...ft., Dia...in. to ...ft., Dia...in. to ...ft.						
Casing height above land surface... 16 ...in., weight...lbs./ft. Wall thickness or gauge No... SDR 21						
TYPE OF SCREEN OR PERFORATION MATERIAL: 1 Steel 3 Stainless steel 5 Fiberglass 8 RMP (SR) 10 Asbestos-cement 2 Brass 4 Galvanized steel 6 Concrete tile 9 ABS 12 Other (specify) ...						
Screen or Perforation Openings Are: 1 Continuous slot 3 Mill slot 5 Gauzed wrapped 8 Saw cut 11 None (open hole) 2 Louvered shutter 4 Key punched 6 Wire wrapped 9 Drilled holes 7 Torch cut 10 Other (specify) ...						
Screen-Perforation Dia... 5 ...in. to 87 ...ft., Dia...in. to ...ft., Dia...in. to ...ft.						
Screen-Perforated Intervals: From... 82 ...ft. to 87 ...ft., From...ft. to ...ft., From...ft. to ...ft.						
Gravel Pack Intervals: From... 70 ...ft. to 87 ...ft., From...ft. to ...ft., From...ft. to ...ft.						
5 GROUT MATERIAL: 1 Heat cement 2 Cement grout 3 Bentonite 4 Other ...						
Grouted Intervals: From... 0 ...ft. to 10 ...ft., From...ft. to ...ft., From...ft. to ...ft.						
What is the nearest source of possible contamination: 1 Septic tank 4 Cess pool 7 Sewage lagoon 10 Fuel storage 14 Abandoned water well 2 Sewer lines 5 Seepage pit 8 Feed yard 11 Fertilizer storage 15 Oil well/Gas well 3 Lateral lines 6 Pit privy 9 Livestock pens 12 Insecticide storage 16 Other (specify below) 13 Watertight sewer lines						
Direction from well... How many feet... ? Water Well Disinfected? Yes... No ...						
Was a chemical/bacteriological sample submitted to Department? Yes... No ... If yes, date sample was submitted... month... day... year: Pump Installed? Yes... No ...						
If Yes: Pump Manufacturer's name... Model No... HP... Volts...						
Depth of Pump Intake... ft. Pumps Capacity rated at... gal./min.						
Type of pump: 1 Submersible 2 Turbine 3 Jet 4 Centrifugal 5 Reciprocating 6 Other						
6 CONTRACTOR'S OR LANDOWNER'S CERTIFICATION: This water well was (1) constructed, (2) reconstructed, or (3) plugged under my jurisdiction and was completed on Sept ...month 29 ...day 1982 ...year						
and this record is true to the best of my knowledge and belief, Kansas Water Well Contractor's License No. ...						
This Water Well Record was completed on March ...month 27 ...day 1983 ...year under the business name of Arthur M. Cobb						
7 LOCATE WELL'S LOCATION WITH AN "X" IN SECTION BOX:		FROM	TO	LITHOLOGIC LOG	FROM	TO
				See log from Site #47(1)		
ELEVATION:						
Depth(s) Groundwater Encountered 1...ft. 2...ft. 3...ft. 4...ft. (Use a second sheet if needed)						
INSTRUCTIONS: Use typewriter or ball point pen, please press firmly and PRINT clearly. Please fill in blanks, underline or circle the correct answers. Send top three copies to Kansas Department of Health and Environment, Division of Environment, Water Well Contractors, Topeka, KS 66620. Send one to WATER WELL OWNER and retain one for your records.						

OFFICE USE ONLY

T

29

R

13

EW

SEC.

12

NE 1/4 NW 1/4 SE 1/4

SITE NUMBER : 47
SITE LOCATION: NW NE NE


LEGAL LOCATION: 12-29-13W
COUNTY : PRATT

[illegible]

TD=87'
82'/5'

SITE NUMBER : 47
SITE LOCATION : NW NW NE
LEGAL LOCATION: 12-29-13W
COUNTY : PRATT

LANDOWNER: DON FINCHAM
ADDRESS :
PHONE NO.: (316)-672-3676

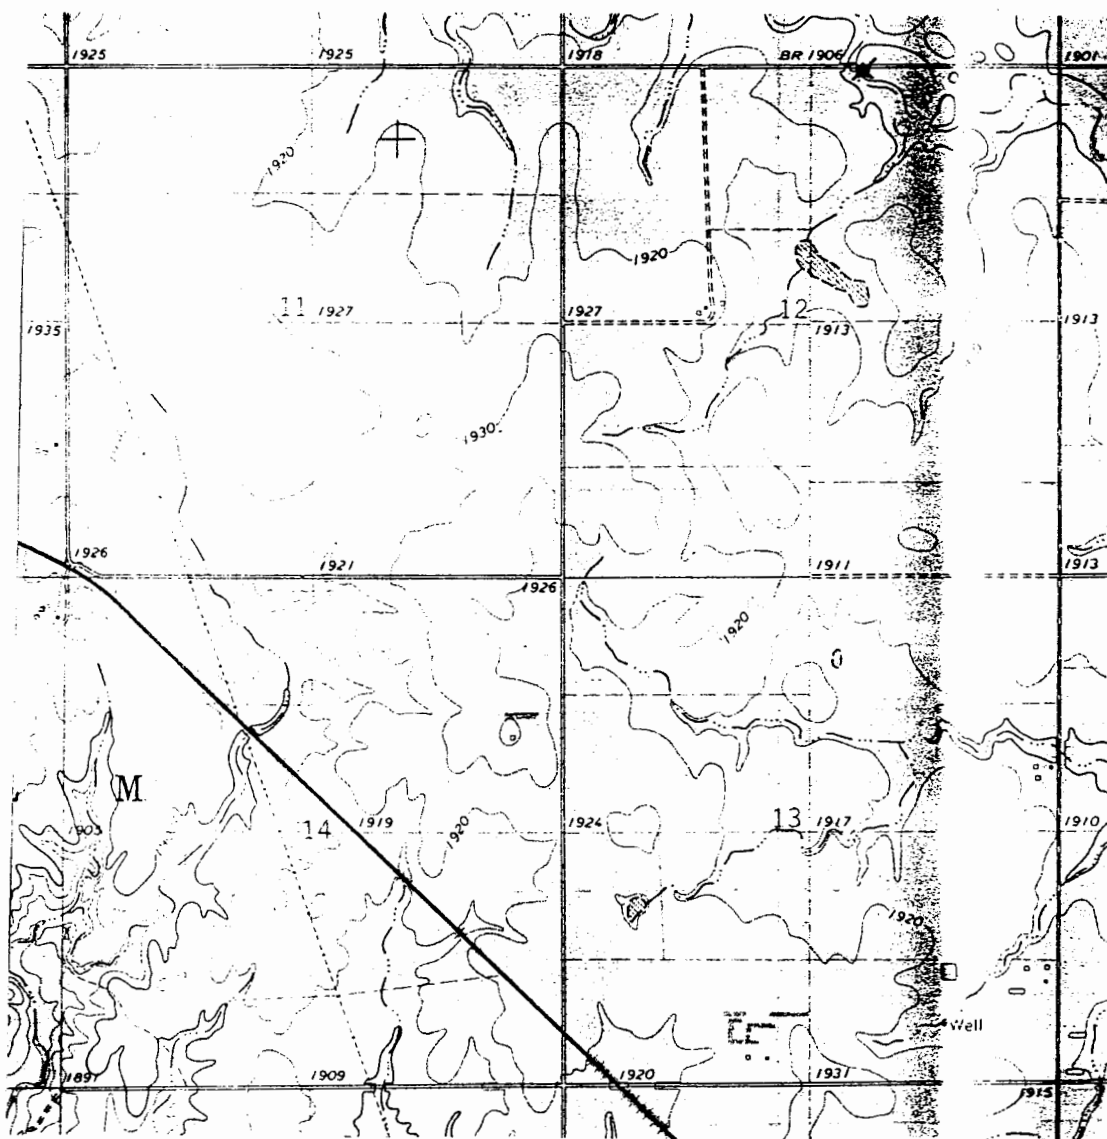

WELL LOCATION X