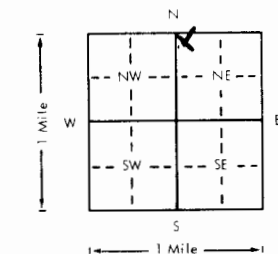


1 LOCATION OF WATER WELL		Fraction		Section Number		Township Number		Range Number	
County: Pratt		NW 1/4 NW 1/4 NE 1/4		12		T 29 S		R 13 EW	
Distance and direction from nearest town or city? 3 mi N, 1/2 mi W of Sawyer				Street address of well if located within city?					
2 WATER WELL OWNER: KGS/GWMD#5									
RR#, St. Address, Box # : City, State, ZIP Code :									
Board of Agriculture, Division of Water Resources Application Number:									
3 DEPTH OF COMPLETED WELL: 165 ft. Bore Hole Diameter: 9-7/8 in. to 165 ft. and 165 in. to 165 ft.									
Well Water to be used as: 1 Domestic 3 Feedlot 5 Public water supply 8 Air conditioning 11 Injection well 2 Irrigation 4 Industrial 6 Oil field water supply 9 Dewatering 12 Other (Specify below) 7 Lawn and garden only 10 Observation well									
Well's static water level 71.7 ft. below land surface measured on January month 27 day 1983 year									
4 TYPE OF BLANK CASING USED: 1 Steel 3 RMP (SR) 5 Wrought iron 8 Concrete tile Casing Joints: Glued <input checked="" type="checkbox"/> Clamped <input type="checkbox"/> 2 PVC 4 ABS 7 Fiberglass 9 Other (specify below) Welded <input type="checkbox"/> Threaded <input type="checkbox"/>									
7 LOCATE WELL'S LOCATION WITH AN "X" IN SECTION BOX:									
									
ELEVATION:									
FROM TO LITHOLOGIC LOG FROM TO LITHOLOGIC LOG									
See log from Site #47(1)									
INSTRUCTIONS: Use typewriter or ball point pen, please press firmly and PRINT clearly. Please fill in blanks, underline or circle the correct answers. Send top three copies to Kansas Department of Health and Environment, Division of Environment, Water Well Contractors, Topeka, KS 66620. Send one to WATER WELL OWNER and retain one for your records.									

SITE NUMBER : 47
SITE LOCATION: NW NE NE

LEGAL LOCATION: 12-29-13W
COUNTY : PRATT


[illegible]

TD=87'

82' / 5'

SITE NUMBER : 47
SITE LOCATION : NW NW NE
LEGAL LOCATION: 12-29-13W
COUNTY : PRATT

LANDOWNER: DON FINCHAM
ADDRESS :
PHONE NO.: (316)-672-3676

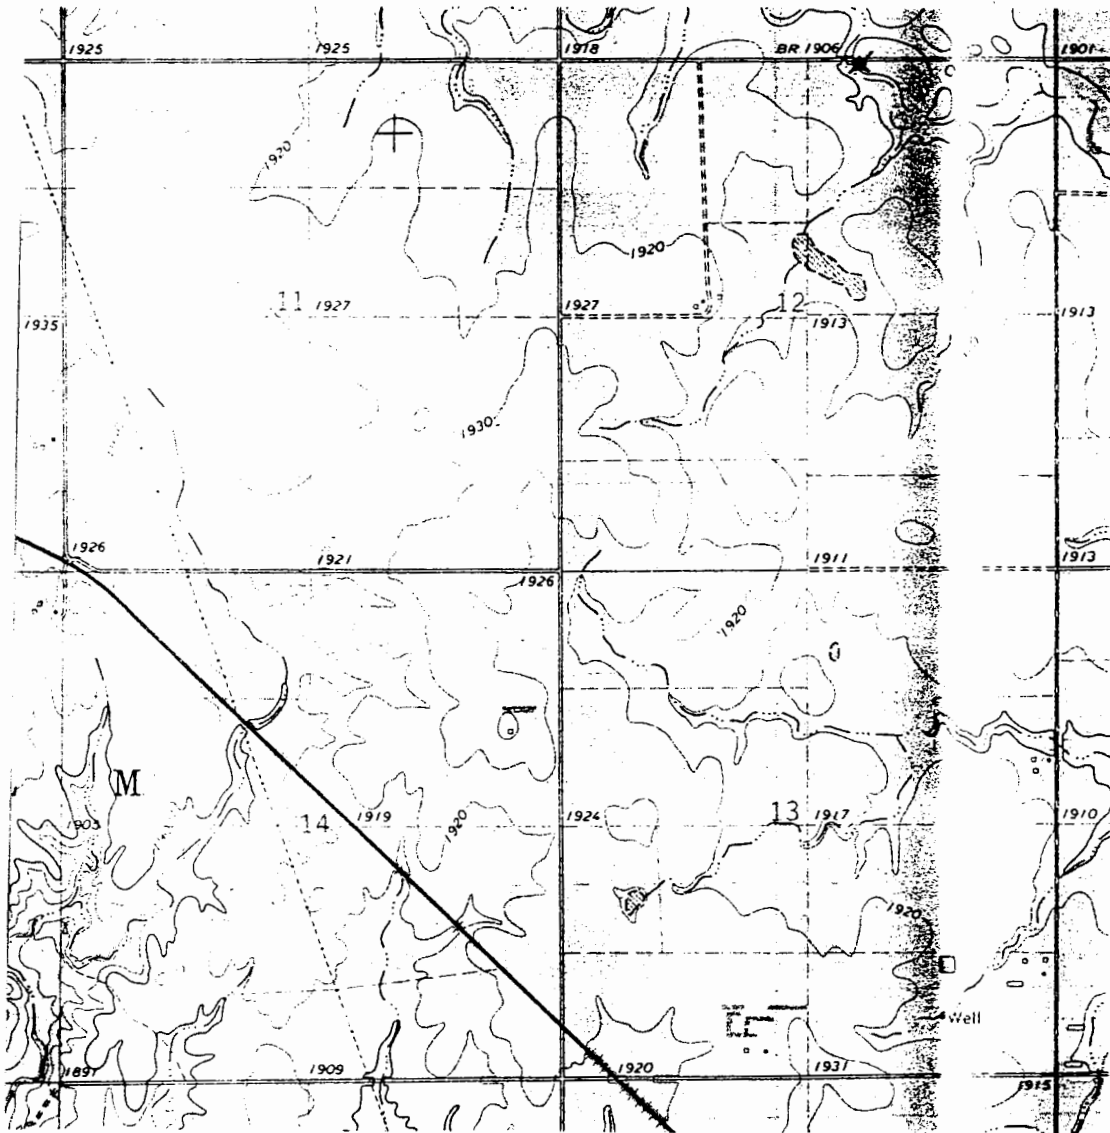

WELL LOCATION X