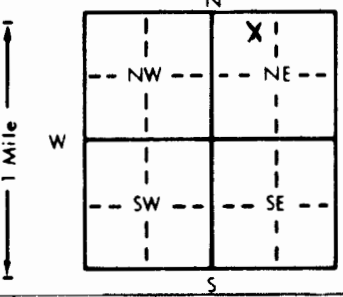


1 LOCATION OF WATER WELL:		Fraction	Section Number		Township Number	Range Number
County: Pratt		NE 1/4 NW 1/4 NE 1/4	28		T 29 S	R 13 E/W
Distance and direction from nearest town or city street address of well if located within city? 3 1/4 west of Sawyer						
2 WATER WELL OWNER: J.O. Farmer						
RR#, St. Address, Box #: P.O. Box 352						
City, State, ZIP Code: Russell, Ks. 67665						
Board of Agriculture, Division of Water Resources Application Number: 940307						
3 LOCATE WELL'S LOCATION WITH AN "X" IN SECTION BOX:		4 DEPTH OF COMPLETED WELL: 148 ft. ELEVATION:				
		Depth(s) Groundwater Encountered 1. ft. 2. ft. 3. ft. WELL'S STATIC WATER LEVEL 85 ft. below land surface measured on mo/day/yr 8-23-94 Pump test data: Well water was ft. after hours pumping gpm Est. Yield NA gpm: Well water was ft. after hours pumping gpm Bore Hole Diameter 10 in. to 148 ft., and in. to ft. WELL WATER TO BE USED AS: 5 Public water supply 8 Air conditioning 11 Injection well 1 Domestic 3 Feedlot 6 Oil field water supply 9 Dewatering 12 Other (Specify below) 2 Irrigation 4 Industrial 7 Lawn and garden only 10 Monitoring well Was a chemical/bacteriological sample submitted to Department? Yes No X; If yes, mo/day/yr sample was submitted Water Well Disinfected? Yes HTH No				
5 TYPE OF BLANK CASING USED:						
1 Steel 3 RMP (SR) 5 Wrought iron 8 Concrete tile CASING JOINTS: Glued X Clamped 2 PVC 4 ABS 6 Asbestos-Cement 9 Other (specify below) Welded 7 Fiberglass Threaded						
Blank casing diameter 5 in. to 108 ft., Dia in. to ft., Dia in. to ft. Casing height above land surface 12 in., weight 258 lbs./ft. Wall thickness or gauge No.						
TYPE OF SCREEN OR PERFORATION MATERIAL:						
1 Steel 3 Stainless steel 5 Fiberglass 8 RMP (SR) 10 Asbestos-cement 2 Brass 4 Galvanized steel 6 Concrete tile 9 ABS 11 Other (specify) 12 None used (open hole)						
SCREEN OR PERFORATION OPENINGS ARE:						
1 Continuous slot 3 Mill slot 5 Gauzed wrapped 8 Saw cut 11 None (open hole) 2 Louvered shutter 4 Key punched 6 Wire wrapped 9 Drilled holes 7 Torch cut 10 Other (specify)						
SCREEN-PERFORATED INTERVALS: From 108 ft. to 148 ft., From ft. to ft. From ft. to ft., From ft. to ft. GRAVEL PACK INTERVALS: From 20 ft. to 148 ft., From ft. to ft. From ft. to ft., From ft. to ft.						
6 GROUT MATERIAL: 1 Neat cement 2 Cement grout 3 Bentonite 4 Other Hole plug						
Grout intervals: From 0 ft. to 20 ft., From ft. to ft., From ft. to ft.						
What is the nearest source of possible contamination:						
1 Septic tank 4 Lateral lines 7 Pit privy 10 Livestock pens 14 Abandoned water well 2 Sewer lines 5 Cess pool 8 Sewage lagoon 11 Fuel storage 15 Oil well/Gas well 3 Watertight sewer lines 6 Seepage pit 9 Feedyard 12 Fertilizer storage 16 Other (specify below) 13 Insecticide storage Direction from well? north How many feet? 900						
LITHOLOGIC LOG						
FROM	TO	LITHOLOGIC LOG			FROM	TO
0	3	Top soil				
3	5	Black clay				
5	15	Brown & White clay				
15	35	Sand and gravel				
35	39	Brown & white clay				
39	70	Sand & gravel				
70	74	Brown & gray clay				
74	110	Sand & gravel				
110	117	Sand & clay mixed				
117	130	Sand & gravel				
130	134	Brown clay				
134	148	Sand & gravel				
7 CONTRACTOR'S OR LANDOWNER'S CERTIFICATION: This water well was (1) constructed, (2) reconstructed, or (3) plugged under my jurisdiction and was completed on (mo/day/year) 8-23-94 and this record is true to the best of my knowledge and belief. Kansas Water Well Contractor's License No. 134 This Water Well Record was completed on (mo/day/yr) 8-26-94 under the business name of Rosencrantz-Bemis by (signature) India Hedson						
INSTRUCTIONS: Use typewriter or ball point pen. PLEASE PRESS FIRMLY and PRINT clearly. Please fill in blanks, underline or circle the correct answers. Send top three copies to Kansas Department of Health and Environment, Bureau of Water, Topeka, Kansas 66620-0001. Telephone: 913-296-5545. Send one to WATER WELL OWNER and retain one for your records.						

OFFICE USE ONLY

T

R

EW

SEC.

1/4

1/4

1/4