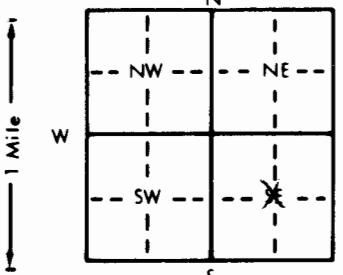


WATER WELL RECORD Form WWC-5 KSA 82a-1212

1 LOCATION OF WATER WELL:		Fraction	Section Number	Township Number	Range Number
County: <u>Pratt</u>		$\frac{1}{4}$ N/C $\frac{1}{4}$ SE $\frac{1}{4}$	<u>29</u>	T <u>29</u> S	R <u>15</u> E/W
Distance and direction from nearest town or city street address of well if located within city? <u>3/4 south, 3/4 east of croft, Ks.</u>					
2 WATER WELL OWNER: <u>Vernon Hirt</u>					
RR#, St. Address, Box #: <u>12640 NW Turket Ln, Road</u>					
City, State, ZIP Code: <u>Sawyer, Ks. 67134</u>					
Board of Agriculture, Division of Water Resources Application Number:					
3 LOCATE WELL'S LOCATION WITH AN "X" IN SECTION BOX:		4 DEPTH OF COMPLETED WELL: <u>172</u> ft. ELEVATION:			
		Depth(s) Groundwater Encountered 1. ft. 2. ft. 3. ft.			
		WELL'S STATIC WATER LEVEL .. <u>84</u> ft. below land surface measured on mo/day/yr .. <u>12-10-97</u> ..			
		Pump test data: Well water was ft. after hours pumping gpm			
		Est. Yield .. <u>na</u> .. gpm: Well water was ft. after hours pumping gpm			
		Bore Hole Diameter .. <u>7</u> .. in. to .. <u>1.72</u> .. ft. and .. in. to .. ft.			
WELL WATER TO BE USED AS:					
1 Domestic 3 Feedlot 6 Oil field water supply 9 Dewatering 12 Other (Specify below)					
2 Irrigation 4 Industrial 7 Lawn and garden only 10 Monitoring well .. <u>Test hole</u> ..					
Was a chemical/bacteriological sample submitted to Department? Yes .. <u>X</u> .. No .. ; If yes, mo/day/yr sample was submitted					
Water Well Disinfected? Yes No <u>X</u>					
5 TYPE OF BLANK CASING USED:					
1 Steel 3 RMP (SR) 6 Asbestos-Cement 9 Other (specify below) Welded					
2 PVC 4 ABS 7 Fiberglass Threaded					
Blank casing diameter .. <u>3</u> .. in. to .. <u>5.160</u> .. ft. Dia .. in. to .. ft. Dia .. in. to .. ft.					
Casing height above land surface .. <u>2</u> .. in. weight .. SCH <u>80</u> .. lbs./ft. Wall thickness or gauge No.					
TYPE OF SCREEN OR PERFORATION MATERIAL:					
1 Steel 3 Stainless steel 5 Fiberglass 8 RMP (SR) 11 Other (specify) ..					
2 Brass 4 Galvanized steel 6 Concrete tile 9 ABS 12 None used (open hole)					
SCREEN OR PERFORATION OPENINGS ARE:					
1 Continuous slot 3 Mill slot 5 Gauzed wrapped 8 Saw cut 11 None (open hole)					
2 Louvered shutter 4 Key punched 6 Wire wrapped 9 Drilled holes					
7 Torch cut 10 Other (specify) ..					
SCREEN-PERFORATED INTERVALS: From .. <u>165</u> .. ft. to .. <u>160</u> .. ft. From .. ft. to .. ft.					
From .. ft. to .. ft. From .. ft. to .. ft.					
GRAVEL PACK INTERVALS: From .. <u>172</u> .. ft. to .. <u>155</u> .. ft. From .. ft. to .. ft.					
From .. ft. to .. ft. From .. ft. to .. ft.					
6 GROUT MATERIAL: 1 Neat cement 2 Cement grout 3 Bentonite 4 Other hole plug .. <u>155 to 153</u> ..					
Grout intervals: From .. <u>153</u> .. ft. to .. <u>53</u> .. ft. From .. ft. to .. ft. From .. <u>53</u> .. ft. to .. <u>0</u> .. ft.					
What is the nearest source of possible contamination:					
1 Septic tank 4 Lateral lines 7 Pit privy 10 Livestock pens 14 Abandoned water well					
2 Sewer lines 5 Cess pool 8 Sewage lagoon 11 Fuel storage 15 Oil well/Gas well					
3 Watertight sewer lines 6 Seepage pit 9 Feedyard 12 Fertilizer storage 16 Other (specify below)					
13 Insecticide storage .. <u>none</u> ..					
Direction from well? How many feet?					
FROM TO LITHOLOGIC LOG FROM TO PLUGGING INTERVALS					
0 2 Top soil					
2 15 Tough dark brown clay					
15 17 Light brown clay					
17 22 White clay					
22 56 Sand and gravel clean, coarse, loose					
56 56 1/2 Clay streaks					
56 1/2 66 Sand and gravel clean, coarse, loose					
66 71 Brown & white clay					
71 123 Sand and gravel clean coarse, loose					
123 146 Brown & white clay					
146 148 Hard white rock					
148 172 Sand and gravel, white rock and little clay					
7 CONTRACTOR'S OR LANDOWNER'S CERTIFICATION: This water well was <u>(1)</u> constructed, (2) reconstructed, or (3) plugged under my jurisdiction and was completed on (mo/day/year) .. <u>12-11-97</u> .. and this record is true to the best of my knowledge and belief. Kansas Water Well Contractor's License No. <u>134</u> This Water Well Record was completed on (mo/day/yr) .. <u>12-12-97</u> .. under the business name of <u>Rosencrantz-Bemis</u> by (signature) <u>Freddie Hedson</u>					
INSTRUCTIONS: Use typewriter or ball point pen. PLEASE PRESS FIRMLY and PRINT clearly. Please fill in blanks, underline or circle the correct answers. Send top three copies to Kansas Department of Health and Environment, Bureau of Water, Topeka, Kansas 66620-0001. Telephone: 913-296-5545. Send one to WATER WELL OWNER and retain one for your records.					