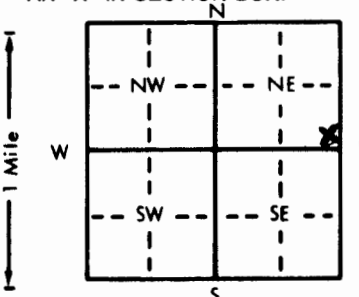


1 LOCATION OF WATER WELL:		Fraction	Section Number	Township Number	Range Number
County: Pratt		SE 1/4 SE 1/4 NE 1/4	5	T 29 S	R 15 EW
Distance and direction from nearest town or city street address of well if located within city? 5 south, 2 west, 1.4 south, 330' west of Cullison, Kansas					
2 WATER WELL OWNER:		Board of Agriculture, Division of Water Resources			
RR#, St. Address, Box # :		Application Number: 784-734			
City, State, ZIP Code :		Wichita, Kansas 67207 Lease: Laird 1-5			
3 LOCATE WELL'S LOCATION WITH AN "X" IN SECTION BOX:		4 DEPTH OF COMPLETED WELL: 80 ft. ELEVATION:			
<div style="text-align: center;"></div>		Depth(s) Groundwater Encountered 1. 26 ft. 2. ft. 3. ft.			
		WELL'S STATIC WATER LEVEL 26 ft. below land surface measured on mo/day/yr 1 Oct. 84			
		Pump test data: Well water was ft. after hours pumping gpm			
		Est. Yield 100 gpm: Well water was ft. after hours pumping gpm			
Bore Hole Diameter 10 in. to 80 ft., and in. to ft.		WELL WATER TO BE USED AS:			
1 Domestic 3 Feedlot 6 Oil field water supply 9 Dewatering 12 Other (Specify below)		5 Public water supply 8 Air conditioning 11 Injection well			
2 Irrigation 4 Industrial 7 Lawn and garden only 10 Observation well					
Was a chemical/bacteriological sample submitted to Department? Yes.....No X; If yes, mo/day/yr sample was submitted					
Water Well Disinfected? Yes X No					
5 TYPE OF BLANK CASING USED:					
1 Steel 3 RMP (SR) 5 Wrought iron 8 Concrete tile CASING JOINTS: Glued X Clamped					
2 PVC 4 ABS 6 Asbestos-Cement 9 Other (specify below) Welded					
7 Fiberglass Threaded					
Blank casing diameter 5 in. to 60 ft., Dia. in. to ft., Dia. in. to ft.					
Casing height above land surface 12 in., weight 2.34 lbs./ft. Wall thickness or gauge No. 214					
TYPE OF SCREEN OR PERFORATION MATERIAL:					
1 Steel 3 Stainless steel 5 Fiberglass 7 PVC 10 Asbestos-cement					
2 Brass 4 Galvanized steel 6 Concrete tile 8 RMP (SR) 11 Other (specify)					
9 ABS 12 None used (open hole)					
SCREEN OR PERFORATION OPENINGS ARE:					
1 Continuous slot 3 Mill slot 5 Gauzed wrapped 8 Saw cut 11 None (open hole)					
2 Louvered shutter 4 Key punched 6 Wire wrapped 9 Drilled holes					
7 Torch cut 10 Other (specify)					
SCREEN-PERFORATED INTERVALS: From 60 ft. to 80 ft., From ft. to ft.					
From ft. to ft., From ft. to ft.					
GRAVEL PACK INTERVALS: From 10 ft. to 80 ft., From ft. to ft.					
From ft. to ft., From ft. to ft.					
6 GROUT MATERIAL: 1 Neat cement 2 Cement grout 3 Bentonite 4 Other					
Grout intervals: From 0 ft. to 10 ft., From ft. to ft., From ft. to ft.					
What is the nearest source of possible contamination:					
1 Septic tank 4 Lateral lines 7 Pit privy 10 Livestock pens 14 Abandoned water well					
2 Sewer lines 5 Cess pool 8 Sewage lagoon 11 Fuel storage 15 Oil well/Gas well					
3 Watertight sewer lines 6 Seepage pit 9 Feedyard 12 Fertilizer storage 16 Other (specify below)					
13 Insecticide storage None					
Direction from well? How many feet?					
FROM	TO	LITHOLOGIC LOG	FROM	TO	LITHOLOGIC LOG
0	2 2	Sandy soil			
2	18 18	Sand, coarse and coarse gravel			
18	24 24	Clay, tan			
24	58	Sand, coarse and coarse gravel			
58	80 17	Sand, coarse and coarse gravel with boulders			
7 CONTRACTOR'S OR LANDOWNER'S CERTIFICATION: This water well was 1 constructed, (2) reconstructed, or (3) plugged under my jurisdiction and was completed on (mo/day/year) 8 Oct. 84 and this record is true to the best of my knowledge and belief. Kansas Water Well Contractor's License No. 325 This Water Well Record was completed on (mo/day/yr) 29 Jan. 85 under the business name of Central Well & Pump Inc. by (signature) <i>[Signature]</i>					
INSTRUCTIONS: Use typewriter or ball point pen, PLEASE PRESS FIRMLY and PRINT clearly. Please fill in blanks, underline or circle the correct answers. Send top three copies to Kansas Department of Health and Environment, Division of Environment, Environmental Geology Section, Topeka, KS 66620. Send one to WATER WELL OWNER and retain one for your records.					

OFFICE USE ONLY

T

29

R

15

EW

SEC.

5

46 1/4

36 1/4




