


1 LOCATION OF WATER WELL:		Fraction	Section Number	Township Number	Range Number
County:	Pratt	NW ¼ SW ¼ NW ¼	16	T 29 S	R 15W EW

Distance and direction from nearest town or city street address of well if located within city?

8 W, 1 N of Coates, Kansas

2	WATER WELL OWNER:	Jiles Perdue	Duke Drilling Co.	Perdue !-A
	RR#, St. Address, Box # :	Route 1	Box 823	Board of Agriculture, Division of Water Resources
	City, State, ZIP Code :	Coates, Ks. 67028	Great Bend, Ks. 67530	Application Number: T87-226

3 LOCATE WELL'S LOCATION WITH AN "X" IN SECTION BOX:

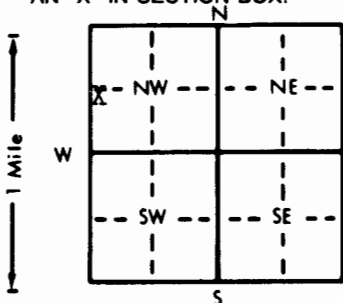

4) DEPTH OF COMPLETED WELL.....160..... ft. ELEVATION: ..Unknown.....

Depth(s) Groundwater Encountered 1. 70..... ft. 2. .... ft. 3. .... ft.

WELL'S STATIC WATER LEVEL .....70. ft. below land surface measured on mo/day/yr .....6/8/87.....

Pump test data: Well water was ..... ft. after ..... hours pumping ..... gpm

Est. Yield ..60... gpm: Well water was ..... ft. after ..... hours pumping ..... gpm

Bore Hole Diameter.....8...in. to ..160.....ft., and.....in. to .....ft.

WELL WATER TO BE USED AS: 5 Public water supply 8 Air conditioning 11 Injection well

1 Domestic 3 Feedlot 6 Oil field water supply 9 Dewatering 12 Other (Specify below)

2 Irrigation 4 Industrial 7 Lawn and garden only 10 Observation well

Was a chemical/bacteriological sample submitted to Department? Yes.....No.....; If yes, mo/day/yr sample was submitted

Water Well Disinfected? Yes No

5	TYPE OF BLANK CASING USED:		5 Wrought iron	8 Concrete tile	CASING JOINTS: <u>Glued</u> . . . . . <u>Clamped</u> . . . . . <u>Welded</u> . . . . . <u>Threaded</u> . . . . .
	1 Steel	3 RMP (SR)	6 Asbestos-Cement	9 Other (specify below)	
	2 PVC	4 ABS	7 Fiberglass		

Blank casing diameter . . . . . 5 . . . in. to . . . 140 . . . ft., Dia . . . . . in. to . . . ft., Dia . . . . . in. to . . . ft.  
Casing height above land surface . . . . . 12 in., weight . . . . . 2.8 . . . lbs./ft. Wall thickness or gauge No. . . . . Sch. 40

TYPE OF SCREEN OR PERFORATION MATERIAL:			<u>7 PVC</u>	10 Asbestos-cement
1 Steel	3 Stainless steel	5 Fiberglass	8 RMP (SR)	11 Other (specify) .....
2 Brass	4 Galvanized steel	6 Concrete tile	9 ABS	12 None used (open hole)

SCREEN OR PERFORATION OPENINGS ARE:

1 Continuous slot	3 Mill slot	5 Gauzed wrapped	8 <u>Saw cut</u>	11 None (open hole)
2 Louvered shutter	4 Key punched	6 Wire wrapped	9 Drilled holes	
		7 Torch cut	10 Other (specify) .....	

SCREEN-PERFORATED INTERVALS: From ..... 140 ..... ft. to ..... 160 ..... ft., From ..... ft. to ..... ft.  
From ..... ft. to ..... ft., From ..... ft. to ..... ft.  
GRAVEL PACK INTERVALS: From ..... 20 ..... ft. to ..... 160 ..... ft., From ..... ft. to ..... ft.  
From ..... ft. to ..... ft., From ..... ft. to ..... ft.

6 GROUT MATERIAL:		1 Neat cement		2 Cement grout		3 Bentonite		4 Other	
Grout Intervals:		From	0	ft. to	20	ft.	From		ft. to

What is the nearest source of possible contamination:

1 Septic tank	4 Lateral lines	7 Pit privy	10 Livestock pens	14 Abandoned water well
2 Sewer lines	5 Cess pool	8 Sewage lagoon	11 Fuel storage	15 <u>Oil well/Gas well</u>
3 Watertight sewer lines	6 Seepage pit	9 Feedyard	12 Fertilizer storage	16 Other (specify below)
			13 Insecticide storage	.....

Direction from well? South How many feet? 60

[illegible]

7. CONTRACTOR'S OR LANDOWNER'S CERTIFICATION: This water well was (1) constructed, (2) reconstructed, or (3) plugged under my jurisdiction and was completed on (mo/day/year) 6/8/87 and this record is true to the best of my knowledge and belief. Kansas Water Well Contractor's License No. 186 This Water Well Record was completed on (mo/day/year) 8/17/87

INSTRUCTIONS: Use typewriter or ball point pen. PLEASE PRESS FIRMLY and PRINT clearly. Please fill in blanks, underline or circle the correct answers. Send top three copies to Kansas Department of Health and Environment, Bureau of Water Protection, Topeka, Kansas 66620-7320, Telephone: 913-862-9360. Send one to WATER WELL OWNER and retain one for your records.