

WATER WELL RECORD Form WWC-5

Division of Water Resources App. No.

20190162


Well ID

Perkins 1

Original Record Correction Change in Well Use

1 LOCATION OF WATER WELL: County: PRATT Fraction: 1/4 NE 1/4 NE 1/4 NW 24 Section Number: 24 Township Number: T 29 S Range Number: R 15 E W

2 WELL OWNER: Last Name: LOTAS First: OPERATING COMPANY LLC Street or Rural Address where well is located (if unknown, distance and direction from nearest town or intersection): If at owner's address, check here:
 Business: LOTAS OPERATING COMPANY LLC Address: 100 S. MAIN STE. 420 FROM COURTS 5 MILES WEST WELL.
 Address: 100 S. MAIN STE. 420 ON SOUTH SIDE OF ROAD.
 City: Wichita State: KS ZIP: 67202

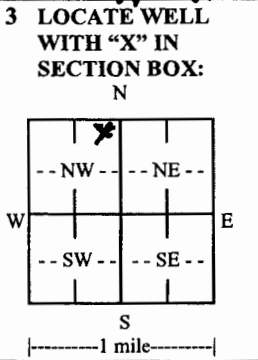

4 DEPTH OF COMPLETED WELL: 195 ft.
 Depth(s) Groundwater Encountered: 1) 195 ft.
 2) 83 ft. 3) 5-15-19 ft., or 4) Dry Well
 WELL'S STATIC WATER LEVEL: 83 ft.
 below land surface, measured on (mo-day-yr) 5-15-19
 above land surface, measured on (mo-day-yr)
 Pump test data: Well water was ft. after hours pumping gpm
 Well water was ft. after hours pumping gpm
 Estimated Yield: gpm
 Bore Hole Diameter: 10 5/8 in. to 200 ft. and in. to ft.

5 Latitude: (decimal degrees)
Longitude: (decimal degrees)
 Horizontal Datum: WGS 84 NAD 83 NAD 27
 Source for Latitude/Longitude:
 GPS (unit make/model:) (WAAS enabled? Yes No)
 Land Survey Topographic Map
 Online Mapper:
6 Elevation: ft. Ground Level TOC
 Source: Land Survey GPS Topographic Map
 Other

7 WELL WATER TO BE USED AS:

1. Domestic: Household Lawn & Garden Livestock
 2. Irrigation
 3. Feedlot
 4. Industrial
 5. Public Water Supply: well ID
 6. Dewatering: how many wells?
 7. Aquifer Recharge: well ID
 8. Monitoring: well ID
 9. Environmental Remediation: well ID
 Air Sparge Soil Vapor Extraction
 Recovery Injection
 10. Oil Field Water Supply: lease Perkins #1
 11. Test Hole: well ID
 Cased Uncased Geotechnical
 12. Geothermal: how many bores?
 a) Closed Loop Horizontal Vertical
 b) Open Loop Surface Discharge Inj. of Water
 13. Other (specify):

Was a chemical/bacteriological sample submitted to KDHE? Yes No If yes, date sample was submitted:
 Water well disinfected? Yes No

8 TYPE OF CASING USED: Steel PVC Other CASING JOINTS: Glued Clamped Welded Threaded
 Casing diameter 5 in. to 175 ft., Diameter in. to ft., Diameter in. to ft.
 Casing height above land surface 24 in. Weight SDR 26 lbs./ft. Wall thickness or gauge No.
 TYPE OF SCREEN OR PERFORATION MATERIAL:
 Steel Stainless Steel Fiberglass PVC Other (Specify)
 Brass Galvanized Steel Concrete tile None used (open hole)
 SCREEN OR PERFORATION OPENINGS ARE:
 Continuous Slot Mill Slot Gauze Wrapped Torch Cut Drilled Holes Other (Specify)
 Louvered Shutter Key Punched Wire Wrapped Saw Cut None (Open Hole)
 SCREEN-PERFORATED INTERVALS: From 175 ft. to 195 ft., From ft. to ft., From ft. to ft.
 GRAVEL PACK INTERVALS: From 195 ft. to 22 ft., From ft. to ft., From ft. to ft.

9 GROUT MATERIAL: Neat cement Cement grout Bentonite Other
 Grout Intervals: From 22 ft. to 0 ft., From ft. to ft., From ft. to ft.
 Nearest source of possible contamination:
 Septic Tank Lateral Lines Pit Privy Livestock Pens Insecticide Storage
 Sewer Lines Cess Pool Sewage Lagoon Fuel Storage Abandoned Water Well
 Watertight Sewer Lines Seepage Pit Feedyard Fertilizer Storage Oil Well/Gas Well
 Other (Specify) 999
 Direction from well? 999 Distance from well? 999 ft.

10 FROM	TO	LITHOLOGIC LOG	FROM	TO	LITHO. LOG (cont.) or PLUGGING INTERVALS
0	10	BRN Sandy Clay			
10	15	White Clay			
15	40	Fine Tan Sand			
40	50	Large gravel			
50	165	Fine Tan Sand			
165	170	Large gravel			
170	190	Fine Tan Sand			
190	200	BRN Sandy Clay/Red Clay mix			

Notes:

11 CONTRACTOR'S OR LANDOWNER'S CERTIFICATION: This water well was constructed, reconstructed, or plugged under my jurisdiction and was completed on (mo-day-year) 5-15-19 and this record is true to the best of my knowledge and belief. Kansas Water Well Contractor's License No. 672 This Water Well Record was completed on (mo-day-year) 5-20-19 under the business name of Crowder's Water Well Serv. Signature