



Distance and direction from nearest town or city street address of well if located within city?
1/2 mile South of Hayward

2 WATER WELL OWNER: Joe Kendall Trust
 RR#, St. Address, Box #: 2530 Danny Lane
 City, State, ZIP Code: Farmers Branch, TX. 75234
 Board of Agriculture, Division of Water Resources
 Application Number:

3 LOCATE WELL'S LOCATION WITH AN "X" IN SECTION BOX:

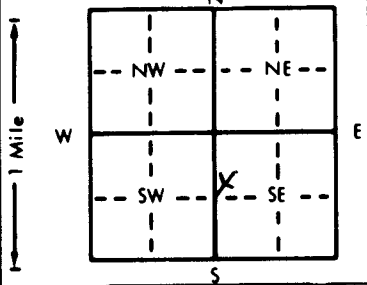

4 DEPTH OF COMPLETED WELL: 130 ft. ELEVATION: _____ ft.
 Depth(s) Groundwater Encountered: 1 ft. 2. _____ ft. 3. _____ ft.
 WELL'S STATIC WATER LEVEL: 60 ft. below land surface measured on mo/day/yr 8-19-99
 Pump test data: Well water was _____ ft. after _____ hours pumping _____ gpm
 Est. Yield 100 gpm; Well water was _____ ft. after _____ hours pumping _____ gpm
 Bore Hole Diameter: 8 3/4 in. to 130 ft., and _____ in. to _____ ft.
 WELL WATER TO BE USED AS:
 5 Public water supply 8 Air conditioning 11 Injection well
 1 Domestic 3 Feedlot 6 Oil field water supply 9 Dewatering 12 Other (Specify below)
 2 Irrigation 4 Industrial 7 Lawn and garden only 10 Monitoring well Livestock
 Was a chemical/bacteriological sample submitted to Department? Yes _____ No X; If yes, mo/day/yr sample was submitted _____
 Water Well Disinfected? Yes X No _____

5 TYPE OF BLANK CASING USED:
 1 Steel 3 RMP (SR) 6 Asbestos-Cement 9 Other (specify below)
2 PVC 4 ABS 7 Fiberglass
 Blank casing diameter: 5 in. to 120 ft., Dia _____ in. to _____ ft., Dia _____ in. to _____ ft.
 Casing height above land surface: 12 in., weight _____ lbs./ft. Wall thickness or gauge No. 30R-26

TYPE OF SCREEN OR PERFORATION MATERIAL:
 1 Steel 3 Stainless steel 5 Fiberglass 7 PVC 10 Asbestos-cement
 2 Brass 4 Galvanized steel 6 Concrete tile 9 ABS 11 Other (specify) _____
 12 None used (open hole)

SCREEN OR PERFORATION OPENINGS ARE:
 1 Continuous slot 3 Mill slot 5 Gauzed wrapped 8 Saw cut 11 None (open hole)
 2 Louvered shutter 4 Key punched 6 Wire wrapped 9 Drilled holes
 7 Torch cut 10 Other (specify) _____

SCREEN-PERFORATED INTERVALS: From 120 ft. to 130 ft., From _____ ft. to _____ ft.
 From _____ ft. to _____ ft., From _____ ft. to _____ ft.
 GRAVEL PACK INTERVALS: From 20 ft. to 130 ft., From _____ ft. to _____ ft.
 From _____ ft. to _____ ft., From _____ ft. to _____ ft.

6 GROUT MATERIAL: 1 Neat cement 2 Cement grout 3 Bentonite 4 Other _____
 Grout Intervals: From 0 ft. to 20 ft., From _____ ft. to _____ ft., From _____ ft. to _____ ft.

What is the nearest source of possible contamination:
 1 Septic tank 4 Lateral lines 7 Pit privy 10 Livestock pens 14 Abandoned water well
 2 Sewer lines 5 Cess pool 8 Sewage lagoon 11 Fuel storage 15 Oil well/Gas well
 3 Watertight sewer lines 6 Seepage pit 9 Feedyard 12 Fertilizer storage 16 Other (specify below)
 13 Insecticide storage
 Direction from well? East How many feet? 1000

FROM	TO	LITHOLOGIC LOG	FROM	TO	PLUGGING INTERVALS
<u>0</u>	<u>10</u>	<u>Ten Sandy Clay</u>			
<u>10</u>	<u>130</u>	<u>Sand & Gravel</u>			

7 CONTRACTOR'S OR LANDOWNER'S CERTIFICATION: This water well was (1) constructed, (2) reconstructed, or (3) plugged under my jurisdiction and was completed on (mo/day/year) 8-19-99 and this record is true to the best of my knowledge and belief. Kansas Water Well Contractor's License No. 653 This Water Well Record was completed on (mo/day/yr) 9-19-99 under the business name of Dan Hayse Water Well Service by (signature) Dan Hayse

OFFICE USE ONLY
T
R
EW
SEC.
1/4
1/4
1/4