


1 LOCATION OF WATER WELL: Fraction $\frac{1}{4}$ C SW $\frac{1}{4}$ NE $\frac{1}{4}$ Section Number 1 Township Number T 29 S Range Number R 16 EW

Distance and direction from nearest town or city street address of well if located within city?
 4 S $\frac{5}{8}$ E $\frac{3}{8}$ S OF WELLSFORD, KS

2 WATER WELL OWNER: Eagle Drilling Co. company
 RR#, St. Address, Box #: Wichita, Kansas
 City, State, ZIP Code: Lease: Dunbar # 5 Board of Agriculture, Division of Water Resources Application Number:

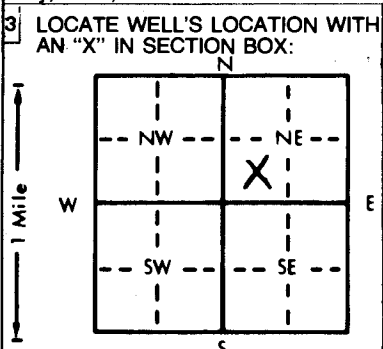

4 DEPTH OF COMPLETED WELL: 110 ft. ELEVATION:
 Depth(s) Groundwater Encountered 1. 75 ft. 2. ft. 3. ft.
 WELL'S STATIC WATER LEVEL 65 ft. below land surface measured on mo/day/yr 20 Nov. 82
 Pump test data: Well water was ft. after hours pumping gpm
 Est. Yield 100 gpm: Well water was ft. after hours pumping gpm
 Bore Hole Diameter 10 in. to 110 ft. and in. to ft.
 WELL WATER TO BE USED AS:
 5 Public water supply 8 Air conditioning 11 Injection well
 1 Domestic 3 Feedlot 6 Oil field water supply 9 Dewatering 12 Other (Specify below)
 2 Irrigation 4 Industrial 7 Lawn and garden only 10 Observation well
 Was a chemical/bacteriological sample submitted to Department? Yes No X If yes, mo/day/yr sample was submitted
 Water Well Disinfected? Yes X No

5 TYPE OF BLANK CASING USED:
 1 Steel 3 RMP (SR) 5 Wrought iron 8 Concrete tile CASING JOINTS: Glued X Clamped
 2 Brass 4 ABS 6 Asbestos-Cement 9 Other (specify below) Welded
 3 PVC 7 Fiberglass Threaded
 Blank casing diameter 5 in. to 90 ft., Dia. in. to ft., Dia. in. to ft.
 Casing height above land surface 12 in., weight lbs./ft. Wall thickness or gauge No. 2/4
 TYPE OF SCREEN OR PERFORATION MATERIAL:
 1 Steel 3 Stainless steel 5 Fiberglass 8 RMP (SR) 11 Other (specify)
 2 Brass 4 Galvanized steel 6 Concrete tile 9 ABS 12 None used (open hole)
 SCREEN OR PERFORATION OPENINGS ARE:
 1 Continuous slot 3 Mill slot 5 Gauzed wrapped 8 Saw cut 11 None (open hole)
 2 Louvered shutter 4 Key punched 6 Wire wrapped 9 Drilled holes
 7 Torch cut 10 Other (specify)
 SCREEN-PERFORATED INTERVALS: From 90 ft. to 110 ft., From ft. to ft.
 GRAVEL PACK INTERVALS: From 10 ft. to 110 ft., From ft. to ft.

6 GROUT MATERIAL: 1 Neat cement 2 Cement grout 3 Bentonite 4 Other
 Grout Intervals: From 0 ft. to 10 ft., From ft. to ft., From ft. to ft.
 What is the nearest source of possible contamination:
 1 Septic tank 4 Lateral lines 7 Pit privy 10 Livestock pens 14 Abandoned water well
 2 Sewer lines 5 Cess pool 8 Sewage lagoon 11 Fuel storage 15 Oil well/Gas well
 3 Watertight sewer lines 6 Seepage pit 9 Feedyard 12 Fertilizer storage 16 Other (specify below)
 13 Insecticide storage NONE
 Direction from well? How many feet?

FROM	TO	LITHOLOGIC LOG	FROM	TO	LITHOLOGIC LOG
0	2	Top soil			
2	5	Clay, brown			
5	55	Sand, fine to coarse and fine to coarse gravel			
55	75	Clay, brown and tan			
75	110	Sand, med to coarse and med to coarse to very coarse gravel			

7 CONTRACTOR'S OR LANDOWNER'S CERTIFICATION: This water well was (1) constructed, (2) reconstructed, or (3) plugged under my jurisdiction and was completed on (mo/day/year) 20 Nov 82 and this record is true to the best of my knowledge and belief. Kansas Water Well Contractor's License No. 325 This Water Well Record was completed on (mo/day/yr) 20 Feb 83 under the business name of Central Well & Pump Inc. by (signature) J. J. Donomuel
 INSTRUCTIONS: Use typewriter or ball point pen, PLEASE PRESS FIRMLY and PRINT clearly. Please fill in blanks, underline or circle the correct answers. Send top three copies to Kansas Department of Health and Environment, Division of Environment, Environmental Geology Section, Topeka, KS 66620. Send one to WATER WELL OWNER and retain one for your records.

DP

OFFICE USE ONLY T 29 R 16 C 1/4 SW 1/4 NE 1/4