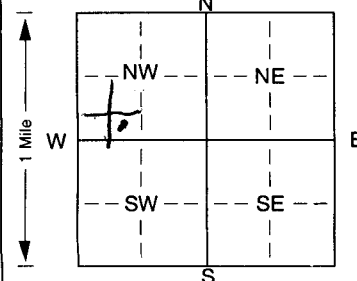


1 LOCATION OF WATER WELL: Fraction E2NW¹/₄ Section Number SW¹/₄ 17 Township Number T 29 Range Number R 16 EW
 County: Wilson

Distance and direction from nearest town or city street address of well if located within city?
West 1/2 ALTON & SOUTH 1/2

2 WATER WELL OWNER: William S. Coltrane & Connie S. Noel
 RR#, St. Address, Box #: 611 OHIO ST Board of Agriculture, Division of Water Resources
 City, State, ZIP Code: Neodesha, KS 66757 Application Number:

3 LOCATE WELL'S LOCATION WITH AN "X" IN SECTION BOX:


4 DEPTH OF COMPLETED WELL: 110.69 ft. ELEVATION:
 Depth(s) Groundwater Encountered 1. 110.69 ft. 2. ft. 3. ft.
 WELL'S STATIC WATER LEVEL: 40 ft. below land surface measured on mo/day/yr
 Pump test data: Well water was ft. after hours pumping gpm
 Est. Yield: 3 gpm: Well water was ft. after hours pumping gpm
 Bore Hole Diameter: 8 in. to 110 ft., and in. to ft.
 WELL WATER TO BE USED AS:
 1 Domestic 3 Feedlot 6 Oil field water supply 9 Dewatering 11 Injection well
 2 Irrigation 4 Industrial 7 Domestic (lawn & garden) 10 Monitoring well
 Was a chemical/bacteriological sample submitted to Department? Yes. No. ; If yes, mo/day/yr sample was submitted
 Water Well Disinfected? Yes No

5 TYPE OF BLANK CASING USED:
 1 Steel 3 RMP (SR) 5 Wrought iron 8 Concrete tile CASING JOINTS: Glued Clamped
 2 PVC 4 ABS 6 Asbestos-Cement 9 Other (specify below) Welded
 7 Fiberglass Threaded
 Blank casing diameter: 5 in. to 110 ft., Dia. in. to ft., Dia. in. to ft.
 Casing height above land surface: 18 in., weight 5 CH 160 lbs./ft. Wall thickness or gauge No.
 TYPE OF SCREEN OR PERFORATION MATERIAL:
 1 Steel 3 Stainless steel 5 Fiberglass 7 PVC 10 Asbestos-cement
 2 Brass 4 Galvanized steel 6 Concrete tile 8 RMP (SR) 11 Other (specify)
 12 None used (open hole)
 SCREEN OR PERFORATION OPENINGS ARE:
 1 Continuous slot 6 Mill slot 5 Gauzed wrapped 8 Saw cut 11 None (open hole)
 2 Louvered shutter 4 Key punched 7 Torch cut 9 Drilled holes
 10 Other (specify) ft.
 SCREEN-PERFORATED INTERVALS: From: 110 ft. to 70 ft., From ft. to ft.
 From ft. to ft., From ft. to ft.
 GRAVEL PACK INTERVALS: From: 110 ft. to 22 ft., From ft. to ft.
 From ft. to ft., From ft. to ft.

6 GROUT MATERIAL: 1 Neat cement 2 Cement grout 3 Bentonite 4 Other
 Grout Intervals: From: 22 ft. to 0 ft., From ft. to ft., From ft. to ft.
 What is the nearest source of possible contamination:
 1 Septic tank 4 Lateral lines 7 Pit privy 10 Livestock pens 14 Abandoned water well
 2 Sewer lines 5 Cess pool 8 Sewage lagoon 11 Fuel storage 15 Oil well/Gas well
 3 Watertight sewer lines 6 Seepage pit 9 Feedyard 12 Fertilizer storage 16 Other (specify below)
 13 Insecticide storage
 Direction from well? How many feet? 100

FROM	TO	LITHOLOGIC LOG	FROM	TO	PLUGGING INTERVALS
0	2	SOIL			
2	10	SANDY CLAY			
10	20	CLAY			
20	23	LIME			
23	69	SHALE & LIME STKS			
69	75	SAND WATER			
75	90	SHALE DARK			RECEIVED
90	95	RED SHALE			OCT 29 2004
95	100	LIME			
100	10	SHALE			BUREAU OF WATER

7 CONTRACTOR'S OR LANDOWNER'S CERTIFICATION: This water well was (1) constructed, (2) reconstructed, or (3) plugged under my jurisdiction and was completed on (mo/day/year) 10-26-04 and this record is true to the best of my knowledge and belief. Kansas Water Well Contractor's Licence No. 512 This Water Well Record was completed on (mo/day/yr) 10.28.04 under the business name of JEFFERSON DRILLING by (signature) Jeffrey