


1 LOCATION OF WATER WELL: County: KIOWA Fraction: NW 1/4 SW 1/4 SW 1/4 Section Number: 5 Township Number: T 29 S Range Number: R 17 E/W

Distance and direction from nearest town or city street address of well if located within city? 4E-3 1/2 S. of Greensburg Kansas

2 WATER WELL OWNER: IGNE Hubert Board of Agriculture, Division of Water Resources
 RR#, St. Address, Box #: Haviland Kansas Application Number:

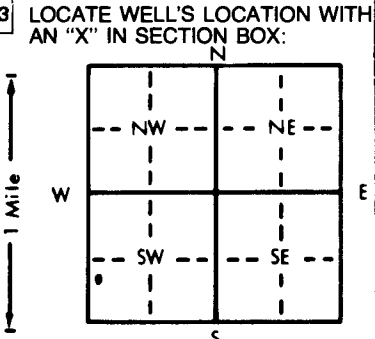

4 DEPTH OF COMPLETED WELL: 163 ft. ELEVATION: ft.
 Depth(s) Groundwater Encountered 1. 105 ft. 2. ft. 3. ft.
 WELL'S STATIC WATER LEVEL 105 ft. below land surface measured on mo/day/yr 5-6-82
 Pump test data: Well water was 105 ft. after 1 hours pumping 10 gpm
 Est. Yield 25 gpm Well water was ft. after hours pumping gpm
 Bore Hole Diameter: 8 3/4 in. to 163 ft., and in. to ft.
 WELL WATER TO BE USED AS: 5 Public water supply 8 Air conditioning 11 Injection well
 Domestic 3 Feedlot 6 Oil field water supply 9 Dewatering 12 Other (Specify below)
 2 Irrigation 4 Industrial 7 Lawn and garden only 10 Observation well
 Was a chemical/bacteriological sample submitted to Department? Yes.....No ; If yes, mo/day/yr sample was submitted
 Water Well Disinfected? Yes No

5 TYPE OF BLANK CASING USED: 1 Steel 2 PVC 3 RMP (SR) 4 ABS 5 Wrought iron 6 Asbestos-Cement 7 Fiberglass 8 Concrete tile 9 Other (specify below) CASING JOINTS: Glued Clamped Welded Threaded.....
 Blank casing diameter 5 in. to 143 ft., Dia in. to ft., Dia in. to ft.
 Casing height above land surface 12 in., weight lbs./ft. Wall thickness or gauge No. SDR-26
 TYPE OF SCREEN OR PERFORATION MATERIAL: 1 Steel 2 Brass 3 Stainless steel 4 Galvanized steel 5 Fiberglass 6 Concrete tile 7 PVC 8 RMP (SR) 9 ABS 10 Asbestos-cement 11 Other (specify) 12 None used (open hole)
 SCREEN OR PERFORATION OPENINGS ARE: 1 Continuous slot 2 Louvered shutter 3 Mill slot 4 Key punched 5 Gauzed wrapped 6 Wire wrapped 7 Torch cut 8 Saw cut 9 Drilled holes 10 Other (specify) 11 None (open hole)
 SCREEN-PERFORATED INTERVALS: From 143 ft. to 163 ft., From ft. to ft.
 GRAVEL PACK INTERVALS: From 120 ft. to 163 ft., From ft. to ft.

6 GROUT MATERIAL: 1 Neat cement 2 Cement grout 3 Bentonite 4 Other
 Grout Intervals: From 4 ft. to 14 ft., From ft. to ft., From ft. to ft.
 What is the nearest source of possible contamination: 1 Septic tank 2 Sewer lines 3 Watertight sewer lines 4 Lateral lines 5 Cess pool 6 Seepage pit 7 Pit privy 8 Sewage lagoon 9 Feedyard 10 Livestock pens 11 Fuel storage 12 Fertilizer storage 13 Insecticide storage 14 Abandoned water well 15 Oil well/Gas well 16 Other (specify below)
 Direction from well? S.W. How many feet? 125

FROM	TO	LITHOLOGIC LOG	FROM	TO	LITHOLOGIC LOG
0	3	Top Soil			
3	10	Bl. Clay			
10	18	Tan Clay			
18	23	Sandy Sandy Clay			
23	62	Tan Clay			
62	156	GRAVEL			
156	163	Clay			

7 CONTRACTOR'S OR LANDOWNER'S CERTIFICATION: This water well was constructed, reconstructed, or plugged under my jurisdiction and was completed on (mo/day/year) 5-6-82 and this record is true to the best of my knowledge and belief. Kansas Water Well Contractor's License No. 224 This Water Well Record was completed on (mo/day/yr) 8-11-82 under the business name of Carl Hayes Water Well Serv. by (signature) Carl Hayes
 INSTRUCTIONS: Use typewriter or ball point pen, PLEASE PRESS FIRMLY and PRINT clearly. Please fill in blanks, underline or circle the correct answers. Send top three copies to Kansas Department of Health and Environment, Division of Environment, Environmental Geology Section, Topeka, KS 66620. Send one to WATER WELL OWNER and retain one for your records.

X 146

OFFICE USE ONLY