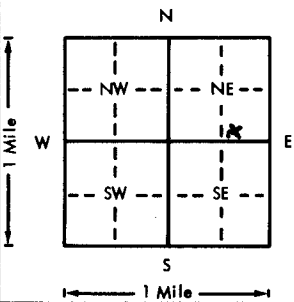


USE TYPEWRITER OR BALL POINT PEN-PRESS FIRMLY, PRINT CLEARLY.

WATER WELL RECORD
KSA 82a-1201-1215

Kansas Department of Health and Environment-Division of Environment
(Water well Contractors)
Topeka, Kansas 66620

1. Location of well: County kiowa Fraction SE 1/4 SE 1/4 NE 1/4 Section number 7 Township number T 29 S Range number R 17 E 1W	
2. Distance and direction from nearest town or city: 4 E 4 1/2 S of Greensburg Street address of well location if in city: Kansas	
3. Owner of well: Leland Schmidt R.R. or street: Greensburg Kansas City, state, zip code: 67054	
4. Locate with "X" in section below: Sketch map: 	
5. Type and color of material	
	From To
Top Soil	0 4
Clay	4 15
Sandy Clay	15 25
Brown Clay	25 35
Gravel Fine - 3/4"	35 136
Clay	136 138
(Use a second sheet if needed)	
18. Elevation: Topography: Hill Slope Upland Valley	19. Remarks:
6. Bore hole dia. 8 3/4 in. Completion date 3-5-76 Well depth 138 ft.	
7. Cable tool <input checked="" type="checkbox"/> Rotary <input type="checkbox"/> Driven <input type="checkbox"/> Dug <input type="checkbox"/> Hollow rod <input type="checkbox"/> Jetted <input type="checkbox"/> Bored <input type="checkbox"/> Reverse rotary	
8. Use: <input checked="" type="checkbox"/> Domestic <input type="checkbox"/> Public supply <input type="checkbox"/> Industry <input type="checkbox"/> Irrigation <input type="checkbox"/> Air conditioning <input type="checkbox"/> Stock <input type="checkbox"/> Lawn <input type="checkbox"/> Oil field water <input type="checkbox"/> Other	
9. Casing: Material Pl Height: Above or below Threaded <input type="checkbox"/> Welded <input checked="" type="checkbox"/> Surface 14 in. RMP <input checked="" type="checkbox"/> PVC <input type="checkbox"/> Weight _____ lbs./ft. Dia. 8 3/4 in. to 138 ft. depth Wall Thickness _____ inches or Dia. _____ in. to _____ ft. depth gage No. 200	
10. Screen: Manufacturer's name Jess & Lowell Type RMP Dia. 5" Slot/gauge 1/8 Length 36' Set between 108 ft. and 138 ft. Gravel pack? <input checked="" type="checkbox"/> Size range of material 4-5 ft.	
11. Static water level: _____ mo./day/yr. 78 ft. below land surface Date 3-5-76	
12. Pumping level below land surfaces: _____ ft. after 1 hrs. pumping 12 g.p.m. _____ ft. after _____ hrs. pumping _____ g.p.m. Estimated maximum yield 25 g.p.m.	
13. Water sample submitted: _____ mo./day/yr. Yes <input checked="" type="checkbox"/> No <input type="checkbox"/> Date _____	
14. Well head completion: <input checked="" type="checkbox"/> Pitless adapter _____ inches above grade	
15. Well grouted? _____ With: <input checked="" type="checkbox"/> Neat cement <input type="checkbox"/> Bentonite <input type="checkbox"/> Concrete Depth: From 4 ft. to 14 ft.	
16. Nearest source of possible contamination: _____ ft. 80 Direction SE Type Septic Well disinfected upon completion? <input checked="" type="checkbox"/> Yes <input type="checkbox"/> No	
17. Pump: Not installed Manufacturer's name Flint & Walling Model number 78912 HP 3/4 Vol 220 Length of drop pipe 105 ft. capacity 10 g.p.m. Type: <input checked="" type="checkbox"/> Submersible <input type="checkbox"/> Turbine <input type="checkbox"/> Jet <input type="checkbox"/> Reciprocating <input type="checkbox"/> Centrifugal <input type="checkbox"/> Other	
20. Water well contractor's certification: This well was drilled under my jurisdiction and this report is true to the best of my knowledge and belief. Carl Kaye Water Well 224 Business name License No. Address Greensburg Kansas Signed Carl Kaye Date 3-5-76 Authorized representative	

29 127 7-SESENE 1/4 14 1/4 W

Forward the white, blue and pink copies to the Department of Health and Environment

Form WWC-5