USE TYPEWRITER OR BALL POINT PEN-PRESS FIRMLY, PRINT CLEARLY.

WATER WELL RECORD
KSA 82a-1201-1215

Kansas Department of Health and Environment-Division of Environment
(Water well Contractors)
Topeka, Kansas 66620

1. Location of well:	County: Kiowa	Fraction: NW 1/4 NW 1/4 NW 1/4	Section number: 9	Township number: T 29 S	Range number: R 17 (W)

2. Distance and direction from nearest town or city: 5E45 Greensburg Kansas
Street address of well location if in city:

3. Owner of well: Leland Schmidt
R.R. or street:
City, state, zip code: Haviland Kansas

4. Locate with "X" in section below: Sketch map:

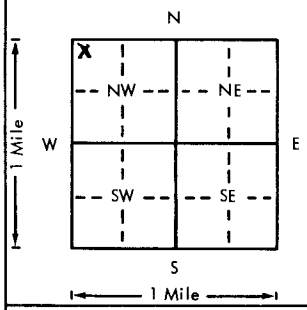

6. Bore hole dia. 8 3/4 in. Completion date
Well depth 130 ft. 6-27-78

7. __ Cable tool X Rotary __ Driven __ Dug
__ Hollow rod __ Jetted __ Bored __ Reverse rotary

8. Use: __ Domestic __ Public supply __ Industry
__ Irrigation __ Air conditioning X Stock
__ Lawn __ Oil field water __ Other

9. Casing: Material PL Height: Above or below
Threaded __ Welded GL Surface 14 in.
RMP X PVC __ Weight __ lbs./ft.
Dia. 5 in. to 130 ft. depth Wall Thickness: inches or
Dia. __ in. to __ ft. depth gage No. 200

5. Type and color of material	From	To
Top Soil	0	2
Clay with Fine Sand	2	23
Gravel	23	130

(Use a second sheet if needed)

10. Screen: Manufacturer's name Sunflower Plastics
Type RMP Dia. 5"
Slot/gauze 18 Length 20
Set between 110 ft. and 130 ft.
__ ft. and __ ft.
Gravel pack? __ Size range of material

11. Static water level: mo./day/yr.
65 ft. below land surface Date 6-27-78

12. Pumping level below land surfaces:
65 ft. after 1 hrs. pumping 3 g.p.m.
__ ft. after __ hrs. pumping __ g.p.m.
Estimated maximum yield 50 g.p.m.

13. Water sample submitted: mo./day/yr.
__ Yes X No Date

14. Well head completion:
__ Pitless adapter 14 Inches above grade

15. Well grouted? X
With: X Neat cement __ Bentonite __ Concrete
Depth: From 0 ft. to 14 ft.

16. Nearest source of possible contamination:
ft. Direction Type
Well disinfected upon completion? __ Yes X No

17. Pump: __ Not installed
Manufacturer's name Layne
Model number LN8 mp Volts
Length of drop pipe 84 ft. capacity 3 g.p.m.
Type:
__ Submersible __ Turbine
__ Jet __ Reciprocating
__ Centrifugal __ Other

18. Elevation:
Topography:
__ Hill
__ Slope
X Upland
__ Valley

19. Remarks:

20. Water well contractor's certification:
This well was drilled under my jurisdiction and this report is true to the best of my knowledge and belief.
CARL HAYSE WATER WELL SERV. 224
Business name License No.
603 S. Maple, Greensburg, Kansas
Address
Signed Carl Hayse Date 6-27-78
Authorized representative

T 29 R 17 Sec 9 1/4 NW 1/4 NW 1/4 NW

Forward the white, blue and pink copies to the Department of Health and Environment

Form WWC-5

MI-1023