


1 LOCATION OF WATER WELL: County: Kiowa Fraction: SE 1/4 NE 1/4 NE 1/4 Section Number: 18 Township Number: T 29 S Range Number: R 17 E **EW**

Distance and direction from nearest town or city street address of well if located within city?  
5 1/2 miles south of Brenham

2 WATER WELL OWNER: Glenn Hubert  
 RR#, St. Address, Box #: \_\_\_\_\_ Board of Agriculture, Division of Water Resources  
 City, State, ZIP Code: Haviland, Kansas 67059 Application Number: \_\_\_\_\_

3 LOCATE WELL'S LOCATION WITH AN "X" IN SECTION BOX:

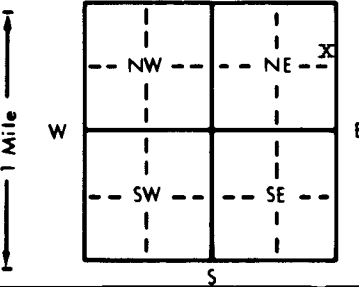

4 DEPTH OF COMPLETED WELL: ~~72~~ 110 ft. ELEVATION: \_\_\_\_\_  
 Depth(s) Groundwater Encountered 1. 72 ft. 2. \_\_\_\_\_ ft. 3. \_\_\_\_\_ ft.  
 WELL'S STATIC WATER LEVEL 72 ft. below land surface measured on mo/day/yr 9/26/89  
 Pump test data: Well water was \_\_\_\_\_ ft. after \_\_\_\_\_ hours pumping \_\_\_\_\_ gpm  
 Est. Yield 60 gpm: Well water was \_\_\_\_\_ ft. after \_\_\_\_\_ hours pumping \_\_\_\_\_ gpm  
 Bore Hole Diameter: 8 3/4 in. to \_\_\_\_\_ ft., and \_\_\_\_\_ in. to \_\_\_\_\_ ft.  
 WELL WATER TO BE USED AS:  
 Domestic    3 Feedlot    6 Oil field water supply    9 Dewatering    12 Other (Specify below)  
 2 Irrigation    4 Industrial    7 Lawn and garden only    10 Monitoring well  
 Was a chemical/bacteriological sample submitted to Department? Yes \_\_\_\_\_ No ; If yes, mo/day/yr sample was sub-  
 mitted \_\_\_\_\_ Water Well Disinfected? Yes  No

5 TYPE OF BLANK CASING USED:  
 1 Steel    3 RMP (SR)    5 Wrought iron    8 Concrete tile    CASING JOINTS: Glued  Clamped \_\_\_\_\_  
 2 PVC    4 ABS    6 Asbestos-Cement    9 Other (specify below)    Welded \_\_\_\_\_  
 7 Fiberglass    Threaded \_\_\_\_\_  
 Blank casing diameter 5 in. to 90 ft., Dia \_\_\_\_\_ in. to \_\_\_\_\_ ft., Dia \_\_\_\_\_ in. to \_\_\_\_\_ ft.  
 Casing height above land surface 12 in., weight \_\_\_\_\_ lbs./ft. Wall thickness or gauge No. SDR-26

TYPE OF SCREEN OR PERFORATION MATERIAL:  
 1 Steel    3 Stainless steel    5 Fiberglass    8 RMP (SR)    10 Asbestos-cement  
 2 Brass    4 Galvanized steel    6 Concrete tile    9 ABS    11 Other (specify) \_\_\_\_\_  
 12 None used (open hole)

SCREEN OR PERFORATION OPENINGS ARE:  
 1 Continuous slot    3 Mill slot    5 Gauzed wrapped    8 Saw cut    11 None (open hole)  
 2 Louvered shutter    4 Key punched    6 Wire wrapped    9 Drilled holes  
 7 Torch cut    10 Other (specify) \_\_\_\_\_

SCREEN-PERFORATED INTERVALS: From 90 ft. to 110 ft., From \_\_\_\_\_ ft. to \_\_\_\_\_ ft.  
 From \_\_\_\_\_ ft. to \_\_\_\_\_ ft., From \_\_\_\_\_ ft. to \_\_\_\_\_ ft.  
 GRAVEL PACK INTERVALS: From 25 ft. to 110 ft., From \_\_\_\_\_ ft. to \_\_\_\_\_ ft.  
 From \_\_\_\_\_ ft. to \_\_\_\_\_ ft., From \_\_\_\_\_ ft. to \_\_\_\_\_ ft.

6 GROUT MATERIAL: 1 Neat cement    2 Cement grout     3 Bentonite    4 Other \_\_\_\_\_  
 Grout Intervals: From 4 ft. to 25 ft., From \_\_\_\_\_ ft. to \_\_\_\_\_ ft., From \_\_\_\_\_ ft. to \_\_\_\_\_ ft.

What is the nearest source of possible contamination:  
 1 Septic tank    4 Lateral lines    7 Pit privy    10 Livestock pens     14 Abandoned water well  
 2 Sewer lines    5 Cess pool    8 Sewage lagoon    11 Fuel storage    15 Oil well/Gas well  
 3 Watertight sewer lines    6 Seepage pit    9 Feedyard    12 Fertilizer storage    16 Other (specify below)  
 13 Insecticide storage \_\_\_\_\_  
 Direction from well? Northwest How many feet? 10

FROM	TO	LITHOLOGIC LOG	FROM	TO	PLUGGING INTERVALS
0	1	Topsoil			
1	3	Brown clay			
3	45	Tan clay			
45	110	Sand & gravel			

7 CONTRACTOR'S OR LANDOWNER'S CERTIFICATION: This water well was (1) constructed, (2) reconstructed, or (3) plugged under my jurisdiction and was completed on (mo/day/year) 9/26/89 and this record is true to the best of my knowledge and belief. Kansas Water Well Contractor's License No. 224 This Water Well Record was completed on (mo/day/yr) 12/22/89 under the business name of Carl Hayse Water Well Service by (signature) Carl Hayse

OFFICE USE ONLY