


26W052 MW-1

| | | | | |
|---|---|----------------------------|----------------------------------|--|
| 1 LOCATION OF WATER WELL: County: <u>kiowa</u> | Fraction <u>NW 1/4 NW 1/4 SE 1/4</u> | Section Number <u>9</u> | Township Number T <u>29</u> S | Range Number R <u>18</u> <u>(W)</u> |
|---|---|----------------------------|----------------------------------|--|

Distance and direction from nearest town or city street address of well if located within city?
4 miles S of Greensburg & 1.5 miles E of Hwy 183

2 WATER WELL OWNER:
RR#, St. Address, Box # : Kiowa County
City, State, ZIP Code : 1002 S. Grove
Greensburg KS 67054

Board of Agriculture, Division of Water Resources
Application Number:

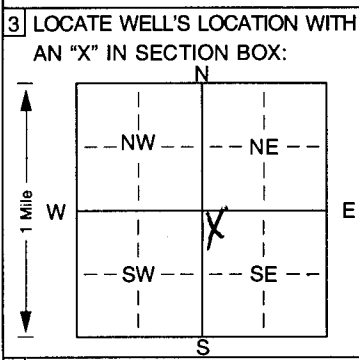

4 DEPTH OF COMPLETED WELL... 149.5 ft. ELEVATION:
Depth(s) Groundwater Encountered 1... 137 ft. 2... ft. 3... ft.
WELL'S STATIC WATER LEVEL 131.52 ft. below land surface measured on mo/day/yr 5/18/00
Pump test data: Well water was ... ft. after ... hours pumping ... gpm
Est. Yield ... gpm: Well water was ... ft. after ... hours pumping ... gpm
Bore Hole Diameter: 8.5 in. to 149.5 ft., and ... in. to ... ft.
WELL WATER TO BE USED AS: 5 Public water supply 8 Air conditioning 11 Injection well
1 Domestic 3 Feedlot 6 Oil field water supply 9 Dewatering 12 Other (Specify below)
2 Irrigation 4 Industrial 7 Domestic (lawn & garden) 10 Monitoring well

Was a chemical/bacteriological sample submitted to Department? Yes. ... No. If yes, mo/day/yr sample was submitted
Water Well Disinfected? Yes No

5 TYPE OF BLANK CASING USED:
1 Steel 3 RMP (SR) 5 Wrought iron 8 Concrete tile CASING JOINTS: Glued. ... Clamped. ...
2 PVC 4 ABS 6 Asbestos-Cement 9 Other (specify below) Welded. ...
Blank casing diameter ... 2 in. to 129 ft., Dia ... in. to ... ft., Dia ... in. to ... ft.
Casing height above land surface: 36 in., weight 0.93 lbs./ft. Wall thickness or gauge No. Sch 80

TYPE OF SCREEN OR PERFORATION MATERIAL:
1 Steel 3 Stainless steel 5 Fiberglass 8 RMP (SR) 10 Asbestos-cement
2 Brass 4 Galvanized steel 6 Concrete tile 9 ABS 11 Other (specify) ...
12 None used (open hole)

SCREEN OR PERFORATION OPENINGS ARE:
1 Continuous slot Mill slot 5 Gauzed wrapped 8 Saw cut 11 None (open hole)
2 Louvered shutter 4 Key punched 6 Wire wrapped 9 Drilled holes
7 Torch cut 10 Other (specify) ... ft.

SCREEN-PERFORATED INTERVALS: From 129 ft. to 149 ft., From ... ft. to ... ft.
GRAVEL PACK INTERVALS: From 125 ft. to 149.5 ft., From ... ft. to ... ft.

6 GROUT MATERIAL: 2 1 Neat cement 2 Cement grout 3 Bentonite 4 Other ...
Grout Intervals: From 2 ft. to 125 ft., From 123 ft. to 125 ft., From ... ft. to ... ft.

What is the nearest source of possible contamination:
1 Septic tank 4 Lateral lines 7 Pit privy 10 Livestock pens 14 Abandoned water well
2 Sewer lines 5 Cess pool 8 Sewage lagoon 11 Fuel storage 15 Oil well/Gas well
3 Watertight sewer lines 6 Seepage pit 9 Feedyard 12 Fertilizer storage 16 Other (specify below)
13 Insecticide storage

Direction from well? How many feet?

| FROM | TO | LITHOLOGIC LOG | FROM | TO | PLUGGING INTERVALS |
|-------|-------|----------------|------|----|--------------------|
| 0 | 4.5 | Silty Clay | | | |
| 4.5 | 36 | Clayey silt | | | |
| 36 | 50 | Silty sand | | | |
| 50 | 60 | Clayey silt | | | |
| 60 | 98.5 | Silt | | | |
| 98.5 | 101.5 | Silty sand | | | |
| 101.5 | 102 | Clayey silt | | | |
| 102 | 149.5 | Sand | | | |

7 CONTRACTOR'S OR LANDOWNER'S CERTIFICATION: This water well was (1) constructed, (2) reconstructed, or (3) plugged under my jurisdiction and was completed on (mo/day/year) 6/19/00 and this record is true to the best of my knowledge and belief. Kansas Water Well Contractor's Licence No. 531. This Water Well Record was completed on (mo/day/yr) 6/29/00 under the business name of Geotechnical Services, Inc. by (signature) Allen M. ...