

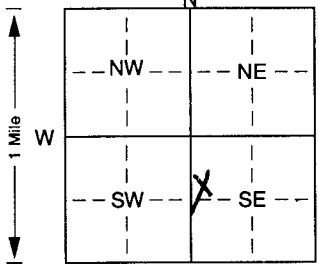
26W052

MW-2

1 LOCATION OF WATER WELL: Fraction SW 1/4 NW 1/4 SE 1/4 Section Number 9 Township Number T 29 S Range Number R 18 (NW)
 County: kiowa

Distance and direction from nearest town or city street address of well if located within city?
4 miles S of Greensburg & 1.5 miles E of Hwy 183

2 WATER WELL OWNER: Kiowa County
 RR#, St. Address, Box #: 1002 S. Bove Board of Agriculture, Division of Water Resources
 City, State, ZIP Code: Greensburg KS 67054 Application Number:

3 LOCATE WELL'S LOCATION WITH AN "X" IN SECTION BOX:


4 DEPTH OF COMPLETED WELL: 151 ft. ELEVATION:
 Depth(s) Groundwater Encountered 1. 141 ft. 2. ft. 3. ft.
 WELL'S STATIC WATER LEVEL 135.62 ft. below land surface measured on mo/day/yr 5/12/00
 Pump test data: Well water was ft. after hours pumping gpm
 Est. Yield gpm: Well water was ft. after hours pumping gpm
 Bore Hole Diameter: 8.5 in. to 15.1 ft., and in. to ft.
 WELL WATER TO BE USED AS: 5 Public water supply 8 Air conditioning 11 Injection well
 1 Domestic 3 Feedlot 6 Oil field water supply 9 Dewatering 12 Other (Specify below)
 2 Irrigation 4 Industrial 7 Domestic (lawn & garden) 10 Monitoring well
 Was a chemical/bacteriological sample submitted to Department? Yes. No X; If yes, mo/day/yrs sample was submitted
 Water Well Disinfected? Yes No X

5 TYPE OF BLANK CASING USED:
 1 Steel 3 RMP (SR) 6 Asbestos-Cement 9 Other (specify below) Welded
2 PVC 4 ABS 7 Fiberglass Threaded Flush
 Blank casing diameter 2 in. to 130.5 ft., Dia in. to ft., Dia in. to ft.
 Casing height above land surface 36 in., weight 0.93 lbs./ft. Wall thickness or gauge No. Sch 80

TYPE OF SCREEN OR PERFORATION MATERIAL:
 1 Steel 3 Stainless steel 5 Fiberglass 8 RMP (SR) 10 Asbestos-cement
 2 Brass 4 Galvanized steel 6 Concrete tile 9 ABS 11 Other (specify)
 12 None used (open hole)

SCREEN OR PERFORATION OPENINGS ARE:
 1 Continuous slot 3 Mill slot 5 Gauzed wrapped 8 Saw cut 11 None (open hole)
 2 Louvered shutter 4 Key punched 6 Wire wrapped 9 Drilled holes
 7 Torch cut 10 Other (specify) ft.

SCREEN-PERFORATED INTERVALS: From 130.5 ft. to 150.5 ft., From ft. to ft.
 From ft. to ft., From ft. to ft.
 GRAVEL PACK INTERVALS: From 126.5 ft. to 151 ft., From ft. to ft.
 From ft. to ft., From ft. to ft.

6 GROUT MATERIAL: 2 Neat cement 2 Cement grout 3 Bentonite 4 Other
 Grout Intervals: From 3 ft. to 124.5 ft., From 124.5 ft. to 126.5 ft., From ft. to ft.

What is the nearest source of possible contamination:
 1 Septic tank 4 Lateral lines 7 Pit privy 10 Livestock pens 14 Abandoned water well
 2 Sewer lines 5 Cess pool 8 Sewage lagoon 11 Fuel storage 15 Oil well/Gas well
 3 Watertight sewer lines 6 Seepage pit 9 Feedyard 12 Fertilizer storage 16 Other (specify below)
 13 Insecticide storage
 Direction from well? How many feet?

FROM	TO	LITHOLOGIC LOG	FROM	TO	PLUGGING INTERVALS
0	10	Silty Clay			
10	34	Clayey silt			
34	37	silt			
37	41	Clayey silt			
41	47	sandy silt			
47	103.5	silt			
103.5	107	Silty sand			
107	151	sand			

7 CONTRACTOR'S OR LANDOWNER'S CERTIFICATION: This water well was (1) constructed, (2) reconstructed, or (3) plugged under my jurisdiction and was completed on (mo/day/year) 6/19/00 and this record is true to the best of my knowledge and belief Kansas
 Water Well Contractor's Licence No. 531 This Water Well Record was completed on (mo/day/yr) 6/29/00
 under the business name of Geotechnical Services, Inc. (signature) Alvin M. [Signature]