


1 LOCATION OF WATER WELL: Fraction Section Number Township Number Range Number
 County: XXXX Kiowa NE ¼ NE ¼ NE ¼ 2 T 29 S R 18 EW

Distance and direction from nearest town or city street address of well if located within city?
 2½ south 2 east of Greensburg, Ks.

2 WATER WELL OWNER: Laurance Schwarm
 RR#, St. Address, Box #: Rt. 2 Board of Agriculture, Division of Water Resources
 City, State, ZIP Code: Greensburg, Ks. 67054 Application Number:

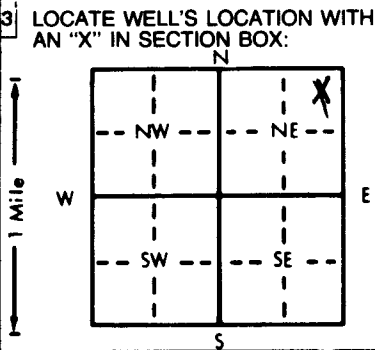

4 DEPTH OF COMPLETED WELL: 190 ft. ELEVATION:
 Depth(s) Groundwater Encountered 1. ft. 2. ft. 3. ft.
 WELL'S STATIC WATER LEVEL . . . 135 . . . ft. below land surface measured on mo/day/yr . . . 11-13-91 . . .
 Pump test data: Well water was ft. after hours pumping gpm
 Est. Yield . . . na . . . gpm: Well water was ft. after hours pumping gpm
 Bore Hole Diameter . . . 10 . . . in. to . . . 190 . . . ft. and in. to ft.
 WELL WATER TO BE USED AS: 5 Public water supply 8 Air conditioning 11 Injection well
 1 Domestic 3 Feedlot 6 Oil field water supply 9 Dewatering 12 Other (Specify below)
 2 Irrigation 4 Industrial 7 Lawn and garden only 10 Monitoring well
 Was a chemical/bacteriological sample submitted to Department? Yes No X; If yes, mo/day/yr sample was submitted
 Water Well Disinfected? Yes hth No

5 TYPE OF BLANK CASING USED: 5 Wrought iron 8 Concrete tile CASING JOINTS: Glued X . . . Clamped . . .
 1 Steel 3 RMP (SR) 6 Asbestos-Cement 9 Other (specify below) Welded
 2 PVC 4 ABS 7 Fiberglass Threaded
 Blank casing diameter 5 . . . in. to . . . 165 . . . ft., Dia in. to ft., Dia in. to ft.
 Casing height above land surface 2 in., weight 258 lbs./ft. Wall thickness or gauge No.
 TYPE OF SCREEN OR PERFORATION MATERIAL: 7 PVC 10 Asbestos-cement
 1 Steel 3 Stainless steel 5 Fiberglass 8 RMP (SR) 11 Other (specify)
 2 Brass 4 Galvanized steel 6 Concrete tile 9 ABS 12 None used (open hole)
 SCREEN OR PERFORATION OPENINGS ARE: 5 Gauzed wrapped 8 Saw cut 11 None (open hole)
 1 Continuous slot 3 Mill slot 6 Wire wrapped 9 Drilled holes
 2 Louvered shutter 4 Key punched 7 Torch cut 10 Other (specify)
 SCREEN-PERFORATED INTERVALS: From 165 ft. to 190 ft., From ft. to ft.
 From ft. to ft., From ft. to ft.
 GRAVEL PACK INTERVALS: From 20 ft. to 190 ft., From ft. to ft.
 From ft. to ft., From ft. to ft.

6 GROUT MATERIAL: 1 Neat cement 2 Cement grout 3 Bentonite 4 Other hole plug
 Grout Intervals: From 3 ft. to 20 ft., From ft. to ft., From ft. to ft.
 What is the nearest source of possible contamination:
 1 Septic tank 4 Lateral lines 7 Pit privy 10 Livestock pens 14 Abandoned water well
 2 Sewer lines 5 Cess pool 8 Sewage lagoon 11 Fuel storage 15 Oil well/Gas well
 3 Watertight sewer lines 6 Seepage pit 9 Feedyard 12 Fertilizer storage 16 Other (specify below)
 13 Insecticide storage
 Direction from well? west How many feet? 75

FROM	TO	LITHOLOGIC LOG	FROM	TO	PLUGGING INTERVALS
0	3	Top soil			
3	35	Brown clay			
35	47	Sandy brown clay			
47	85	Brown clay little white rock			
85	115	Sand and gravel clean coarse loose			
115	121	Sandy brown clay			
121	145	Sand and gravel clean coarse loose			
145	146½	Cemented sand			
146½	190	Sand and gravel			

7 CONTRACTOR'S OR LANDOWNER'S CERTIFICATION: This water well was (1) constructed, (2) reconstructed, or (3) plugged under my jurisdiction and was completed on (mo/day/year) . . . 11-21-91 and this record is true to the best of my knowledge and belief. Kansas Water Well Contractor's License No. . . 134 This Water Well Record was completed on (mo/day/yr) . . . 11-27-91 under the business name of Rosencrantz-Bemis by (signature) Freddie Jackson

INSTRUCTIONS: Use typewriter or ball point pen. PLEASE PRESS FIRMLY and PRINT clearly. Please fill in blanks, underline or circle the correct answers. Send top three copies to Kansas Department of Health and Environment, Bureau of Water, Topeka, Kansas 66620-0001. Telephone: 913-296-5545. Send one to WATER WELL OWNER and retain one for your records.

OFFICE USE ONLY
T
R
EW
SEC.
¼
¼
¼