


1 LOCATION OF WATER WELL: Fraction C 1/4 SW 1/4 SW 1/4 Section Number 11 Township Number T 29 **S** Range Number R 18 **W**  
 County: Kiowa

Distance and direction from nearest town or city street address of well if located within city?  
 4 1/2 South, 3 East, .87 South, 660' East of 54 & 183 Jct. near Greensburg, Kansas

2 WATER WELL OWNER: Freeman Drilling Company  
 RR#, St. Address, Box #: Box 307 Board of Agriculture, Division of Water Resources  
 City, State, ZIP Code: Pratt, Kansas 67124 Lease: Slief # 1 Application Number:

3 LOCATE WELL'S LOCATION WITH AN "X" IN SECTION BOX:

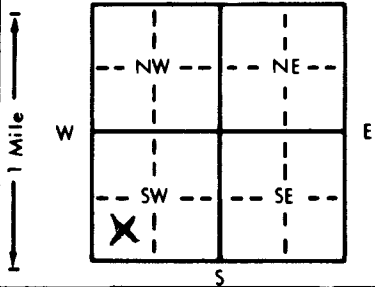

4 DEPTH OF COMPLETED WELL: 140 ft. ELEVATION:  
 Depth(s) Groundwater Encountered 1. 87 ft. 2. ft. 3. ft.  
 WELL'S STATIC WATER LEVEL: 87 ft. below land surface measured on mo/day/yr 3 Jan. 85  
 Pump test data: Well water was ft. after hours pumping gpm  
 Est. Yield 80 gpm: Well water was ft. after hours pumping gpm  
 Bore Hole Diameter: 10 in. to 140 ft. and in. to ft.  
 WELL WATER TO BE USED AS:  
 5 Public water supply 8 Air conditioning 11 Injection well  
 1 Domestic 3 Feedlot **6** Oil field water supply 9 Dewatering 12 Other (Specify below)  
 2 Irrigation 4 Industrial 7 Lawn and garden only 10 Observation well  
 Was a chemical/bacteriological sample submitted to Department? Yes No **X**; If yes, mo/day/yr sample was submitted  
 Water Well Disinfected? Yes **X** No

5 TYPE OF BLANK CASING USED:  
 1 Steel 3 RMP (SR) 5 Wrought iron 8 Concrete tile CASING JOINTS: Glued **X** Clamped  
**2** PVC 4 ABS 7 Fiberglass 9 Other (specify below) Welded  
 Blank casing diameter 5 in. to 120 ft. Dia in. to ft. Dia in. to ft.  
 Casing height above land surface 12 in., weight 2.34 lbs./ft. Wall thickness or gauge No. 214

TYPE OF SCREEN OR PERFORATION MATERIAL:  
 1 Steel 3 Stainless steel 5 Fiberglass **7** PVC 10 Asbestos-cement  
 2 Brass 4 Galvanized steel 6 Concrete tile 8 RMP (SR) 11 Other (specify)  
 12 None used (open hole)  
 SCREEN OR PERFORATION OPENINGS ARE:  
 1 Continuous slot 3 Mill slot 5 Gauzed wrapped **8** Saw cut 11 None (open hole)  
 2 Louvered shutter 4 Key punched 6 Wire wrapped 9 Drilled holes  
 7 Torch cut 10 Other (specify)

SCREEN-PERFORATED INTERVALS: From 120 ft. to 140 ft. From ft. to ft. From ft. to ft.  
 GRAVEL PACK INTERVALS: From 10 ft. to 140 ft. From ft. to ft. From ft. to ft.

6 GROUT MATERIAL: 1 Neat cement **2** Cement grout 3 Bentonite 4 Other  
 Grout Intervals: From 0 ft. to 10 ft. From ft. to ft. From ft. to ft.

What is the nearest source of possible contamination:  
 1 Septic tank 4 Lateral lines 7 Pit privy 10 Livestock pens 14 Abandoned water well  
 2 Sewer lines 5 Cess pool 8 Sewage lagoon 11 Fuel storage 15 Oil well/Gas well  
 3 Watertight sewer lines 6 Seepage pit 9 Feedyard 12 Fertilizer storage 16 Other (specify below)  
 13 Insecticide storage None

Direction from well? How many feet?

FROM	TO	LITHOLOGIC LOG	FROM	TO	LITHOLOGIC LOG
0	2	Soil, top			
2	46	Clay, white and caliche			
46	71	Clay, tan			
71	85	Sand, cemented			
85	116	Sand, fine to coarse and fine to med gravel			
116	140	Sand, coarse and coarse gravel			

7 CONTRACTOR'S OR LANDOWNER'S CERTIFICATION: This water well was **1** constructed, (2) reconstructed, or (3) plugged under my jurisdiction and was completed on (mo/day/year) 7 Jan. 85 and this record is true to the best of my knowledge and belief. Kansas Water Well Contractor's License No. 325. This Water Well Record was completed on (mo/day/yr) 3 June 85 under the business name of Central Well & Pump Inc. by signature *Johnomell*

INSTRUCTIONS: Use typewriter or ball point pen, PLEASE PRESS FIRMLY and PRINT clearly. Please fill in blanks, underline or circle the correct answers. Send top three copies to Kansas Department of Health and Environment, Division of Environment, Environmental Geology Section, Topeka, KS 66620. Send one to WATER WELL OWNER and retain one for your records.

OFFICE USE ONLY T R EW SEC 1/4 1/4 1/4