

1 LOCATION OF WATER WELL: County: Kiowa	Fraction C E 1/2 1/4 SW 1/4 SE 1/4	Section Number 17	Township Number T 29 S	Range Number R 18 E/W
---	--	-----------------------------	----------------------------------	---------------------------------


Distance and direction from nearest town or city street address of well if located within city?

5 3/4 south 1/8 west of Greensburg

2 WATER WELL OWNER: Slawson Drilling RR#, St. Address, Box # : Box 1409 City, State, ZIP Code : Great Bend, Ks. 67530	Board of Agriculture, Division of Water Resources Application Number: T81-621
--	---

3 LOCATE WELL'S LOCATION WITH AN "X" IN SECTION BOX:

4 DEPTH OF COMPLETED WELL... **185**..... ft. ELEVATION:

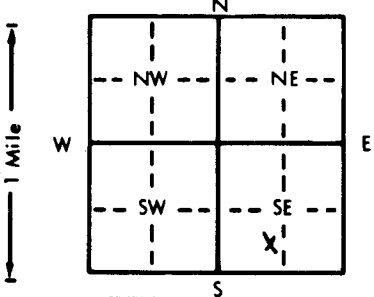

Depth(s) Groundwater Encountered 1. ft. 2. ft. 3. ft.

WELL'S STATIC WATER LEVEL **150**..... ft. below land surface measured on mo/day/yr **9-11-81**.....

Pump test data: Well water was ft. after hours pumping gpm

Est. Yield **NA** ... gpm: Well water was ft. after hours pumping gpm

Bore Hole Diameter... **11**...in. to **185**.....ft., and.....in. to.....ft.

WELL WATER TO BE USED AS: 5 Public water supply 8 Air conditioning 11 Injection well

1 Domestic 3 Feedlot 6 Oil field water supply 9 Dewatering 12 Other (Specify below)

2 Irrigation 4 Industrial 7 Lawn and garden only 10 Observation well

Was a chemical/bacteriological sample submitted to Department? Yes.....No.. **x**.....; If yes, mo/day/yr sample was submitted

Water Well Disinfected? Yes **HTH** No

5 TYPE OF BLANK CASING USED:	3 RMP (SR)	8 Concrete tile	CASING JOINTS: Glued x Clamped
1 Steel	6 Asbestos-Cement	9 Other (specify below)	Welded
6 PVC	7 Fiberglass		Threaded
4 ABS			

Blank casing diameter **.5**.....in. to **155**.....ft., Dia.....in. to.....ft., Dia.....in. to.....ft.

Casing height above land surface..... **18**.....in., weight..... lbs./ft. Wall thickness or gauge No. **258**.....

TYPE OF SCREEN OR PERFORATION MATERIAL:

1 Steel	3 Stainless steel	5 Fiberglass	7 PVC	10 Asbestos-cement
2 Brass	4 Galvanized steel	6 Concrete tile	8 RMP (SR)	11 Other (specify)
			9 ABS	12 None used (open hole)

SCREEN OR PERFORATION OPENINGS ARE:

1 Continuous slot	3 Mill slot	5 Gauzed wrapped	6 Saw cut	11 None (open hole)
2 Louvered shutter	4 Key punched	6 Wire wrapped	9 Drilled holes	
		7 Torch cut	10 Other (specify)	

SCREEN-PERFORATED INTERVALS: From..... **155**..... ft. to **185**.....ft., From..... ft. to.....ft.

GRAVEL PACK INTERVALS: From..... **10**..... ft. to **185**.....ft., From..... ft. to.....ft.

6 GROUT MATERIAL:	0 Neat cement	2 Cement grout	3 Bentonite	4 Other
-------------------	---------------	----------------	-------------	---------------

Grout Intervals: From..... **0**.....ft. to **20**.....ft., From.....ft. to.....ft., From.....ft. to.....ft.

What is the nearest source of possible contamination:

1 Septic tank	4 Lateral lines	7 Pit privy	10 Livestock pens	14 Abandoned water well
2 Sewer lines	5 Cess pool	8 Sewage lagoon	11 Fuel storage	15 Oil well/Gas well
3 Watertight sewer lines	6 Seepage pit	9 Feedyard	12 Fertilizer storage	16 Other (specify below)
			13 Insecticide storage	

Direction from well? **West** How many feet? **75**

FROM	TO	LITHOLOGIC LOG	FROM	TO	LITHOLOGIC LOG
0	2	Top soil			
2	10	Brown clay			
10	65	Brown and white clay			
65	135	Brown and white sandy clay			
135	144	Sand and gravel			
144	149	Cemented sand			
149	154	Sandy clay			
154	176	Sand and gravel			
176	180	Brown clay			
180	185	Shell			

7 CONTRACTOR'S OR LANDOWNER'S CERTIFICATION: This water well was (0) constructed, (2) reconstructed, or (3) plugged under my jurisdiction and was completed on (mo/day/year) **9-11-81**..... and this record is true to the best of my knowledge and belief. Kansas Water Well Contractor's License No. **134**..... This Water Well Record was completed on (mo/day/yr) **9-16-81**..... under the business name of **Rosencrantz-Bemis Ent.** by (signature) *Jora Dodson*

INSTRUCTIONS: Use typewriter or ball point pen, PLEASE PRESS FIRMLY and PRINT clearly. Please fill in blanks, underline or circle the correct answers. Send top three copies to Kansas Department of Health and Environment, Division of Environment, Environmental Geology Section, Topeka, KS 66620. Send one to WATER WELL OWNER and retain one for your records.